


15-167-20573-00-00

STATE OF KANSAS  
STATE CORPORATION COMMISSION

Form CP-4

WELL PLUGGING RECORD

Give All Information Completely  
Make Required Affidavit  
Mail or Deliver Report to:  
Conservation Division  
State Corporation Commission  
P. O. Box 17027  
Wichita, Kansas 67217  
NORTH

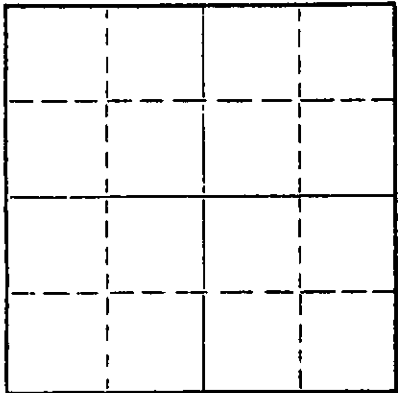

Locate well correctly on above  
Section Plat

Russell County, Sec. 13 Twp. 14 Rge. 12 (E) W (W)  
Location as "NE/CNW&SW" or footage from lines NE SE SW  
Lease Owner Frank W. Vishnefske  
Lease Name Herbel Well No. 1  
Office Address 119 South Santa Fe, Salina, Kansas 67401  
Character of Well (completed as Oil, Gas or Dry Hole) Dry hole  
Date well completed 11-5-1972  
Application for plugging filed 11-5-1972  
Application for plugging approved 11-5-1972  
Plugging commenced 11-5-1972  
Plugging completed 11-5-1972  
Reason for abandonment of well or producing formation Dry hole

If a producing well is abandoned, date of last production 19  
Was permission obtained from the Conservation Division or its agents before plugging was commenced? Yes

Name of Conservation Agent who supervised plugging of this well Don Truan  
Producing formation \_\_\_\_\_ Depth to top \_\_\_\_\_ Bottom \_\_\_\_\_ Total Depth of Well 3,232 Feet  
Show depth and thickness of all water, oil and gas formations.

OIL, GAS OR WATER RECORDS

CASING RECORD

FORMATION	CONTENT	FROM	TO	SIZE	PUT IN	PULLED OUT
				8 5/8"	268'	Cmtd. w/135 sax

Describe in detail the manner in which the well was plugged, indicating where the mud fluid was placed and the method or methods used in introducing it into the hole. If cement or other plugs were used, state the character of same and depth placed, from \_\_\_\_\_ feet to \_\_\_\_\_ feet for each plug set.

Fill hole w/heavy mud  
Push bridge plug to 400'  
Spot 40 sax cement on plug thru 4 1/2" drill pipe  
Fill hole w/heavy mud  
Push bridge plug to 250'  
Spot 25 sax cement on plug thru 4 1/2" drill pipe  
Fill hole w/heavy mud  
Push bridge plug to 40' w/1/2 sax hulls on plug  
Dump 10 sax cement on plug to cellar

RECEIVED  
STATE CORPORATION COMMISSION  
NOV 13 1972  
11-13-72  
CONSERVATION DIVISION  
Wichita, Kansas

(If additional description is necessary, use BACK of this sheet)  
Name of Plugging Contractor Shields Drilling Co., Inc.  
Address Shields Bldg., Russell, Kansas

STATE OF KANSAS, COUNTY OF RUSSELL, ss.  
Robert J. Shields (employee of owner) or (lessee or operator) contractor of the above-described well, being first duly sworn on oath, says: That I have knowledge of the facts, statements, and matters herein contained and the log of the above-described well as filed and that the same are true and correct. So help me God.  
(Signature) Robert J. Shields  
Shields Bldg., Russell, Kansas (Address)

SUBSCRIBED AND SWORN TO before me this 10th day of November, 1972

My commission expires May 26, 1975  
Luth Phillips Notary Public.



Shields


15-167-20573-00-00

Russell, Kansas

WELL LOG

Operator: Frank W. Vishnefske  
 Well: Herbel #1  
 Commenced: October 28, 1972  
 Completed: November 5, 1972  
 Contractor: Shields Drilling Co., Inc.

Well Description: NE SE SW  
 Sec. 13-14S-12W  
 Russell Co., Kansas

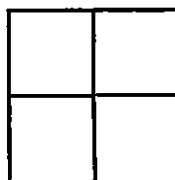

CASING RECORD		
Size	Run	Pulled
8 5/8"	268'	Cmtd. w/135 sax

Elevation: 1,729' RB  
 Treatment:  
 Production: D & A  
 Tops:

..... Figures Indicate Bottom of Formations .....

Top soil, clay & shale	275'
Shale, sand & redbed	583'
Anhydrite	614'
Shale & shells	1,300'
Shale & lime	2,503'
Lime	3,232' RTD

RECEIVED  
 STATE CORPORATION COMMISSION  
 NOV 13 1972  
 11-13-1972  
 CONSERVATION DIVISION  
 Wichita, Kansas

Notes