


15-167-00170-00-00

STATE OF KANSAS  
STATE CORPORATION COMMISSION

Give All Information Completely  
Make Required Affidavit  
Mail or Deliver Report to:  
Conservation Division  
State Corporation Commission  
800 Bittling Building  
Wichita, Kansas

WELL PLUGGING RECORD

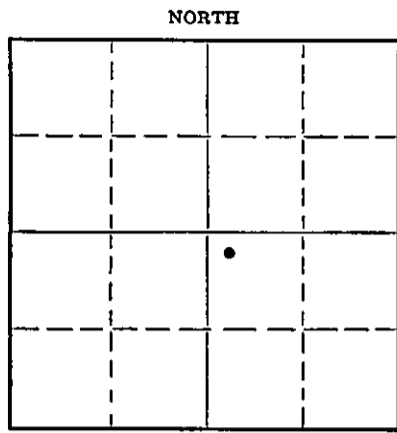

Locate well correctly on above  
Section Plat

Russell County County. Sec. 12 Twp. 14 Rge. (E) 12 (W)  
Location as "NE/CNW $\frac{1}{4}$ /SW $\frac{1}{4}$ " or footage from lines 330' WL 330' NL of SE/4  
Lease Owner Bay Petroleum Co.  
Lease Name Anschutz Well No. 1  
Office Address Chase, Kansas  
Character of Well (completed as Oil, Gas or Dry Hole) Dry Hole  
Date well completed March 7, 19 51  
Application for plugging filed March 7, 19 51  
Application for plugging approved March 7, 19 51  
Plugging commenced March 7, 19 51  
Plugging completed March 7, 19 51  
Reason for abandonment of well or producing formation Dry Hole

If a producing well is abandoned, date of last production 19  
Was permission obtained from the Conservation Division or its agents before plugging was commenced? Yes

Name of Conservation Agent who supervised plugging of this well Eldon Petty  
Producing formation Depth to top Bottom Total Depth of Well 3300 Feet  
Show depth and thickness of all water, oil and gas formations.

OIL, GAS OR WATER RECORDS

CASING RECORD

Formation	Content	From	To	Size	Put In	Pulled Out
		0	154	8 5/8"	154	None

Describe in detail the manner in which the well was plugged, indicating where the mud fluid was placed and the method or methods used in introducing it into the hole. If cement or other plugs were used, state the character of same and depth placed, from feet to feet for each plug set.

Filled with heavy mud to 150'.  
Set plug @ 150'.  
Cemented with 15 sacks thru drill pipe.  
Filled with heavy mud to 40'.  
Set plug at 40'.  
Dumped 3 sack hulls.  
Cemented thru drill pipe to bottom callar with 10 sacks.

03-15-1951

(If additional description is necessary, use BACK of this sheet)

Correspondence regarding this well should be addressed to Bay Petroleum Company  
Address Chase, Kansas

STATE OF Kansas, COUNTY OF Barton, ss.  
A. L. Jackson, drilling contractor, of the above-described well,  
being first duly sworn on oath, says: That I have knowledge of the facts, statements, and matters herein contained and the log of the above-described well as filed and that the same are true and correct. So help me God.

(Signature) A L Jackson  
Great Bend, Kansas  
(Address)

SUBSCRIBED AND SWORN to before me this 12th day of March, 19 51  
Notary Public

My commission expires May 9, 1951.

PLUGGING  
SEE SEC 12-14 N 18 W  
PAGE 66 LINE 32

15-167-00170-00-00

WELL LOG  
Anschutz #1  
NW/4-NW/4-SE/4  
12-14S-12W  
Russell County, Kansas

Date commenced - February 24, 1951  
Date completed - March 7, 1951  
Total depth - 3300'

0-254	Lime, shale, shells - surface pipe @ 154'
254-425	Red bed, shale and shells
425-595	Red bed and shale
595-625	Anhydrite
625-830	Red bed, shale and shells
830-1260	Shale and shells
1260-1435	Lime and shale
1435-2040	Lime and shale
2040-2195	Shale and shells
2195-2390	Shells and shale
2390-2535	Shale
2535-2695	Lime and shale
2695-2805	Lime
2805-2895	Lime and shale
2895-2899	Shale
2899-2935	Lime
2935-3030	Lime
3030-3149	Lime and shale
3149-3165	Lime
3165-3188	Lime and shale
3188-3220	Long cherty
3220-3249	Chert lime
3249-3265	Lime
3265-3300	Arbuckle lime
3300'	Total Depth

I, A. L. Jackson of the Jackson-Lindsley Drilling Company, being first duly sworn, on oath, state; that I have knowledge of the facts, statements, and matters contained herein and that the same are true and correct to the best of my knowledge and belief.

A. L. Jackson  
Partner

Subscribed and sworn to before me this 12 day of March, 1951.

PLUGGING  
FILE SEC 12 T 14 R 12  
BOOK PAGE 66 OF 37

CONSERVATION  
Wilton, Kansas  
Alvin D. Davis  
Notary Public

My commission expires May 9, 1951

03-15-1951