


STATE OF KANSAS
STATE CORPORATION COMMISSION

Give All Information Completely
Make Required Affidavit
Mail or Deliver Report to:
Conservation Division
State Corporation Commission
212 North Market, Insurance Bldg.
Wichita, Kansas

15-167-00653-00-00
WELL PLUGGING RECORD

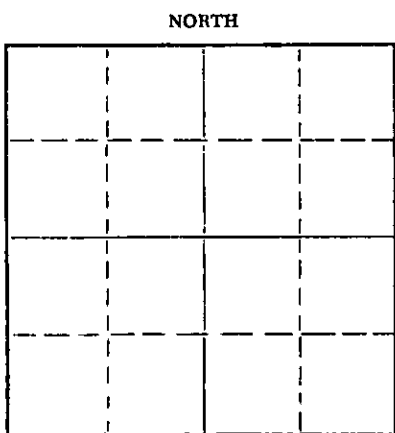

Locate well correctly on above
Section Plat

RUSSELL County. Sec. 11 Twp. 14 Rge. 13 (E) W (W)
Location as "NE/CNWxSWx" or footage from lines SW SW SE
Lease Owner SOLAR OIL COMPANY
Lease Name CAMPBELL Well No. 1
Office Address 1117 Union National Building Wichita, Kansas
Character of Well (completed as Oil, Gas or Dry Hole) Dry Hole
Date well completed April 2 19 63
Application for plugging filed April 2 19 63
Application for plugging approved April 2 (verbally) 19 63
Plugging commenced April 2 19 63
Plugging completed April 2 19 63
Reason for abandonment of well or producing formation _____

If a producing well is abandoned, date of last production _____ 19 ____
Was permission obtained from the Conservation Division or its agents before plugging was commenced? Yes

Name of Conservation Agent who supervised plugging of this well _____
Producing formation _____ Depth to top _____ Bottom _____ Total Depth of Well 3427 Feet
Show depth and thickness of all water, oil and gas formations.

OIL, GAS OR WATER RECORDS

CASING RECORD

| FORMATION | CONTENT | FROM | TO | SIZE | PUT IN | PULLED OUT |
|-----------|---------|------|------|--------|--------|------------|
| Surface | | 0 | 557½ | 8 5/8" | 557½' | none |
| | | | | | | |
| | | | | | | |
| | | | | | | |

Describe in detail the manner in which the well was plugged, indicating where the mud fluid was placed and the method or methods used in introducing it into the hole. If cement or other plugs were used, state the character of same and depth placed, from _____ feet to _____ feet for each plug set.

Filled hole from total depth to 350' with plug, 1/4 sack hulls, and 25 sacks of cement. Heavy mud to 40' with plug, and 15 sacks of cement at this point.

RECEIVED
STATE CORPORATION COMMISSION

APR 12 1963

CONSERVATION DIVISION
Wichita, Kansas

(If additional description is necessary, use BACK of this sheet)

Name of Plugging Contractor HARMS DRILLING COMPANY
Address P.O. Box 488 Great Bend, Kansas

STATE OF KANSAS, COUNTY OF BARTON, ss.
ALLAN HARMS (employee of owner) or (owner or operator) of the above-described well, being first duly sworn on oath, says: That I have knowledge of the facts, statements, and matters herein contained and the log of the above-described well as filed and that the same are true and correct. So help me God.

(Signature) [Signature]
P.O. Box 488 Great Bend, Kansas
(Address)

SUBSCRIBED AND SWORN TO before me this 9th day of April, 19 63

[Signature]
Helen E. Gearhart
Notary Public.

My commission expires 1-22-66



D R I L L E R S L O G

COMPANY: SOLAR OIL COMPANY
 FARM: CAMPBELL #1
 COMMENCED: MARCH 22, 1963

SW SW SE SECTION 11-14-13W
 RUSSELL COUNTY, KANSAS
 COMPLETED: APRIL 2, 1963

ELEVATION: 1883 KB

| | |
|-------------|-----------------|
| 0 - 40 | post lime |
| 40 - 250 | shale |
| 250 - 340 | sand |
| 340 - 495 | red bed & shale |
| 495 - 821 | red bed |
| 821 - 860 | anhydrite |
| 860 - 1500 | red bed & shale |
| 1500 - 1600 | shale-lime |
| 1600 - 2140 | lime-shale |
| 2140 - 2280 | shale-lime |
| 2280 - 2455 | lime-shale |
| 2455 - 2702 | shale-lime |
| 2702 - 2765 | lime-shale |
| 2765 - 2825 | shale-lime |
| 2825 - 2969 | lime |
| 2969 - 2972 | Heebner |
| 2972 - 3001 | Toronto |
| 3001 - 3032 | Douglas shale |
| 3032 - 3412 | lime |
| 3412 - 3427 | Arbuckle |
| 3427 | Total Depth |

SET 557½' of 8 5/8" surface casing. Cemented with 300 sacks of cement with 2% gel and 2% calcium chloride.

| | | | |
|-------|-----------|---|------|
| TOPS: | Anhydrite | - | 821 |
| | Heebner | - | 2969 |
| | Toronto | - | 2972 |
| | Douglas | - | 3001 |
| | Lansing | - | 3032 |
| | Arbuckle | - | 3412 |

RECEIVED
 STATE CORPORATION COMMISSION

APR 12 1963

CONSERVATION DIVISION
 Wichita, Kansas

DRY, plugged, and abandoned

A F F I D A V I T

STATE OF KANSAS)
) SS
 COUNTY OF BARTON)

I, Allan Harms of the Harms Drilling Company being first duly sworn on oath state: I have knowledge of the facts, statements and matters herein contained and the same are true and correct.

Allan Harms
 Allan Harms

Subscribed and sworn to before me this 9th day of April, 1963.

Helen E. Gearhart
 Helen E. Gearhart
 Notary Public

My Commission Expires: 1-22-66.