


WELL PLUGGING RECORD

Give All Information Completely
Make Required Affidavit
Mail or Deliver Report to:
Conservation Division
State Corporation Commission
800 Bittling Building
Wichita, Kansas

NORTH

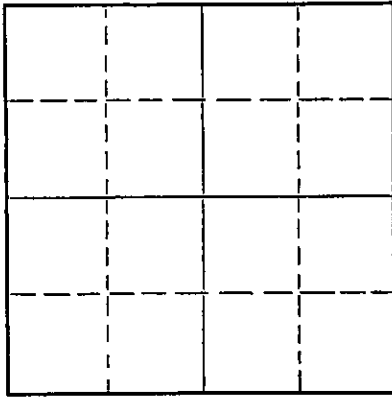

Locate well correctly on above
Section Plat

Russell County. Sec. 10 Twp. 14 Rge. 13 (E) W (W)
Location as "NE/CNWK/SWK" or footage from lines SW NW SW
Lease Owner Icer Addis
Lease Name Boller Well No. 1
Office Address Russell, Kansas
Character of Well (completed as Oil, Gas or Dry Hole) Dry Hole
Date well completed January 15 19 54
Application for plugging filed January 15 19 54
Application for plugging approved January 15 19 54
Plugging commenced January 15 19 54
Plugging completed January 15 19 54
Reason for abandonment of well or producing formation _____

If a producing well is abandoned, date of last production _____ 19____
Was permission obtained from the Conservation Division or its agents before plugging was commenced? Yes

Name of Conservation Agent who supervised plugging of this well Warren Horner, Great Bend, Kansas
Producing formation _____ Depth to top _____ Bottom _____ Total Depth of Well 2387 Feet
Show depth and thickness of all water, oil and gas formations.

OIL, GAS OR WATER RECORDS

CASING RECORD

FORMATION	CONTENT	FROM	TO	SIZE	PUT IN	PULLED OUT

Describe in detail the manner in which the well was plugged, indicating where the mud fluid was placed and the method or methods used in introducing it into the hole. If cement or other plugs were used, state the character of same and depth placed, from _____ feet to _____ feet for each plug set.

Heavy mud to 200', 1/3 sack of hulls. Halliburton plug and 15 sacks of cement poured through drill pipe. Mud to 35' - 1/3 sack of hulls - Halliburton plug and 10 sacks of cement.

RCW
02-26-54

(If additional description is necessary, use BACK of this sheet)

Name of Plugging Contractor Mast Drilling, Inc.
Address P.O. Box 33, Russell, Kansas


STATE OF Kansas COUNTY OF Russell, ss.
agent for operator James J. Addis (employee of owner) or (owner or operator) of the above-described well, being first duly sworn on oath, says That I have knowledge of the facts, statements, and matters herein contained and the log of the above-described well as filed and that the same are true and correct. So help me God.

(Signature) James J. Addis
Russell, Kansas (Address)

SUBSCRIBED AND SWORN TO before me this 25 day of February, 19 54

My commission expires 3-27-57

Samuel C. ... Notary Public.

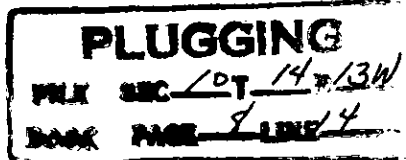

15-167-00177-00-00

OPERATOR: Icer Addis
Russell, Kansas

CONTRACTOR: Mast Drilling, Inc.
Russell, Kansas

BOLLER # 1
SW/4 NW/4 SW/4
Sec. 10, Twp. 14, R. 13,
Russell County, Kansas

COMM: 1-8-54
and
COMP: 1-15-54

FORMATION

DEPTH

Surface Clay - Rock	40
Clay - Shale	195
Blue Shale	208
Shale	265
Sand	325
Shale	360
Sand	398
Shale	420
Red Rock	781
Anhydrite	817
Shale - Shells	1430
Lime - Shale	1668
Lime	1855
Shale - Lime	1907
Lime	1965
Shale - Lime	1970
Shale - Lime	2337
Shale	2347
Coring	2387
 TOTAL DEPTH	 2387

STATE OF KANSAS

COUNTY OF RUSSELL

I hereby certify that the above information is true and correct to the best of my knowledge.

Louis M. Mai

Subscribed and sworn to before me this 28 day of January, 1954.

Shirley Freeman

Notary Public

My Commission Expires: 3/27/57

