


STATE OF KANSAS
STATE CORPORATION COMMISSION

Give All Information Completely
Make Required Affidavit
Mail or Deliver Report to:
Conservation Division
State Corporation Commission
800 Bittling Building
Wichita, Kansas

15-167-05678-00-00
WELL PLUGGING RECORD

NORTH

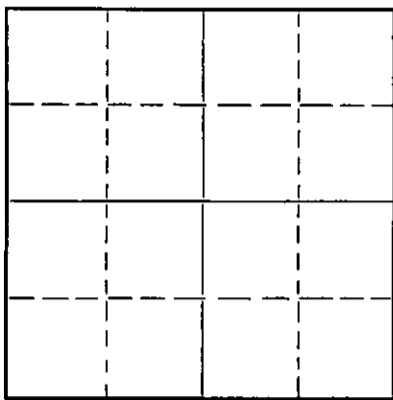

Locate well correctly on above
Section Plat

Russell County. Sec. 7 Twp. 14 Rge. 13 (E) W (W) AUG
Location as "NE/CNW $\frac{1}{4}$ /SW $\frac{1}{4}$ " or footage from lines ~~SW SW W/2 SE~~ SE 1/4 SE
Lease Owner Chet Loving et al
Lease Name Ehrlich "B" Well No. 2
Office Address 907 East Second St., Russell, Kansas
Character of Well (completed as Oil, Gas or Dry Hole) Oil
Date well completed 19
Application for plugging filed May 20, 1956 19
Application for plugging approved May 24, 1956 19
Plugging commenced June 15, 1956 19
Plugging completed June 30, 1956 19
Reason for abandonment of well or producing formation
No longer profitable
If a producing well is abandoned, date of last production May 15, 1956
Was permission obtained from the Conservation Division or its agents before plugging was commenced? YES

Name of Conservation Agent who supervised plugging of this well Milton Galyardt
Producing formation Tarkeo Depth to top 2396 Bottom Total Depth of Well Feet
Show depth and thickness of all water, oil and gas formations.

OIL, GAS OR WATER RECORDS

CASING RECORD

Formation	Content	From	To	Size	Put In	Pulled Out

Describe in detail the manner in which the well was plugged, indicating where the mud fluid was placed and the method or methods used in introducing it into the hole. If cement or other plugs were used, state the character of same and depth placed, from feet to feet for each plug set.

Fill hole with sand to 2348'. Dump five sacks cement; pull pipe to 600'; pumped eight sacks mud; pull pipe to 300'; pump two sacks mud and 60 sacks cement, pull pipe out, bailed mud to 30'; put in rock bridge to 25'. Mix and run ten sacks cement; fill to base of cellar.

07-10-56

(If additional description is necessary, use BACK of this sheet)

Correspondence regarding this well should be addressed to Arnett Casing Pulling Company (Plugging Contractor)
Address Hoisington, Kansas

STATE OF Kansas, COUNTY OF Russell, ss.
Chester Loving (employee of owner) or (owner or operator) of the above-described well, being first duly sworn on oath, says: That I have knowledge of the facts, statements, and matters herein contained and the log of the above-described well as filed and that the same are true and correct. So help me God.

(Signature) *Chester Loving*

(Address)

SUBSCRIBED AND SWORN to before me this 9th day of July, 1956, at Wichita, Kansas.

W. J. ...
Notary Public.

My commission expires 9-14-57

PLUGGING
FILE SEC 7 T 14 R 13 W
BOOK PAGE 64 LINE 24

15-167-05678-00-00


WELL LOG BUREAU--KANSAS GEOLOGICAL SOCIETY
508 East Murdock, Wichita, Kansas

Company- SHUMAKER & MEYER
Farm- Ehrlich "B" No.2

SEC. 7 T. 14 R. 13W
SE SW SE

Total Depth. 2396
Comm. 6-10-53 Comp. 7-15-53
Shot or Treated.
Contractor.
Issued. 11-14-53

County Russell
KANSAS

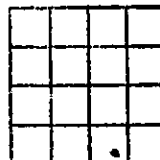

Elevation. 1818

Production. Pmp. 25 & 25 wtr

CASING:

8 " 798'
5 " 2396'

Figures indicate Bottom of Formations.

cellar	8	shale & shells	2260
post rock	15	limo	2270
yellow clay	25	shale	2300
mud	120	limo	2315
shale	270	shale red	2320
clay yellow	280	lime	2325
shale	300	shale sholls	2349
sand	315	shale	2352
sandy shale	330	red rock	2358
shale	335	sand	2361
shale red	350	shale	2364
sand	372	sandy shale	2396
shale	385	Total Depth	
red rock	395		
sand	405		
shale	440	SCOUT TOPS:	
sand	450	1st Tarkio	2358
red rock	793	2nd Tarkio	2380
anhydrite lime	800		
lime	830		
red rock	993		
shale	1035		
shale brown	1075		
shale	1180		
salt	1435		
shale	1440		
shale sholls	1470		
lime	1495		
shale	1510		
lime	1520		
shale	1525		
lime	1530		
shale	1535		
lime	1575		
shale red	1580		
shale	1590		
lime	1600		
shale	1610		
lime	1635		
red rock	1640		
shale sholls	1675		
lime	1692		
red rock	1710		
lime	1755		
shale blue	1760		
lime	1840		
shale blue	1850		
red rock	1860		
lime	1925		
shale	1930		
lime	1965		
shale brown	1970		
lime	2050		
red rock	2070		
lime	2120		
shale	2130		
shale & sholls	2155		
shale sholls	2182		
lime	2190		
shale sholls	2225		

PLUGGING
FILE SEC. 7 T. 14 R. 13W
BOOK PAGE 64 LINE 24