


STATE OF KANSAS
STATE-CORPORATION COMMISSION

Give All Information Completely
Make Required Affidavit
Mail or Deliver Report to:
Conservation Division
State Corporation Commission
212 North Market, Insurance Bldg.
Wichita, Kansas

15-167-00117-00-00
WELL PLUGGING RECORD

NORTH

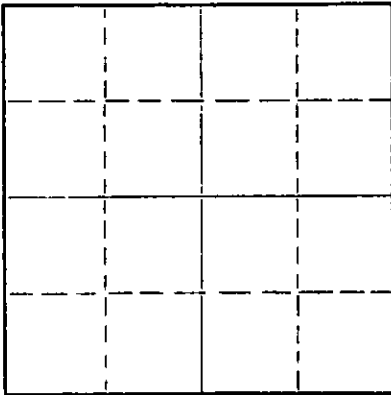

Locate well correctly on above
Section Plot

Russell County, Sec. 12 Twp. 14 Rge. 14 (E) 14 (W)
Location as "NE/CNW/SW" or footage from lines NE NE NE
Lease Owner JOHN O. FARMER, INC.
Lease Name DRISCOLL Well No. 1
Office Address Russell, Kansas
Character of Well (completed as Oil, Gas or Dry Hole) Dry
Date well completed 9/17 19 59
Application for plugging filed 9/17 19 59
Application for plugging approved 9/17 19 59
Plugging commenced 9/17 19 59
Plugging completed 9/17 19 59
Reason for abandonment of well or producing formation Dry

If a producing well is abandoned, date of last production 19
Was permission obtained from the Conservation Division or its agents before plugging was commenced? yes

Name of Conservation Agent who supervised plugging of this well Don Truan
Producing formation _____ Depth to top _____ Bottom _____ Total Depth of Well 3386 Feet
Show depth and thickness of all water, oil and gas formations.

OIL, GAS OR WATER RECORDS

CASING RECORD

FORMATION	CONTENT	FROM	TO	SIZE	PUT IN	PULLED OUT
				8-5/8"	297'	None

Describe in detail the manner in which the well was plugged, indicating where the mud fluid was placed and the method or methods used in introducing it into the hole. If cement or other plugs were used, state the character of same and depth placed, from _____ feet to _____ feet for each plug set.

First plug set at 290 feet with 25 sacks cement

Second plug set at 40 feet with 10 sacks cement

10-01-59

(If additional description is necessary, use BACK of this sheet)

Name of Plugging Contractor JOHN O. FARMER, INC.
Address Russell, Kansas

STATE OF Kansas, COUNTY OF Russell, ss.

I, JOHN O. FARMER (owner or operator) of the above-described well, being first duly sworn on oath, says: That I have knowledge of the facts, statements, and matters herein contained and the log of the above-described well as filed and that the same are true and correct. So help me God.

(Signature)

John O. Farmer
Russell, Kansas


(Address)

SUBSCRIBED AND SWORN TO before me this 19th day of September, 19 59.

My commission expires October 11, 1962

Lucille Kennedy
Lucille Kennedy

Notary Public.

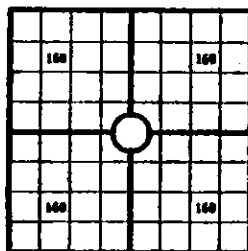OPERATOR JOHN O. FARMER, INC.ADDRESS Russell, Kansas640 Acres
N

Locate well correctly

COUNTY Russell SEC. 12 TWP. 14S RGE. 14WCOMPANY OPERATING JOHN O. FARMER, INC.OFFICE ADDRESS Russell, KansasDRILLING STARTED 9/6, 1959, DRILLING FINISHED 9/16, 1959

DATE OF FIRST PRODUCTION _____ COMPLETED _____

WELL LOCATED NE 1/4 NE 1/4 NE 1/4, North of South
Line and _____ ft. East of West Line of Quarter SectionElevation (Relative to sea level) DERRICK FLOOR 1851 GROUND, 1848CHARACTER OF WELL (Oil, gas or dryhole) Dry

OIL OR GAS SANDS OR ZONES

Name	From	To	Name	From	To
1			4		
2			5		
3			6		

Perforating Record If Any

Shot Record

Formation	From	To	No. of Shots	Formation	From	To	Size of Shot

CASING RECORD

Amount Set						Amount Pulled		Packer Record	
Size	Wt.	Thds.	Make	Ft.	In.	Ft.	In.	Size	Length
8-5/8				297					

Liner Record: Amount _____ Kind _____ Top _____ Bottom _____

CEMENTING AND MUDDING

Size	Amount Set Ft.	In.	Sacks Cement	Chemical Gal.	Make	Method of Cementing	Amount	Mudding Method	Results (See Note)
8-5/8	297		150						

Note: What method was used to protect sands if outer strings were pulled?

NOTE: Were bottom hole plugs used? _____ If so, state kind, depth set and results obtained _____

TOOLS USED

Rotary Tools were used from _____ feet to _____ Cable tools were used from _____ feet to _____
_____ feet, and from _____ feet to _____ feet, and from _____ feet to _____

Type Rig _____

INITIAL PRODUCTION TEST

Describe initial test: whether by flow through tubing or casing or by pumping _____

Amount of Oil Production _____ bbls. Size of choke, if any _____ Length of test _____ Water

Production _____ bbls. Gravity of oil _____ Type of Pump if pump is used, describe _____

FORMATION RECORD

Give detailed description and thickness of all formation drilled through, contents of sand, whether dry, water, oil or gas.

Formation	Top	Bottom	Formation	Top	Bottom
FARM NAME.			DRISCOLL #1		
Shale	0	345			
Pyrite & shells	345	442	ELEVATION: RB	1853	
Shale-shells & sand	442	550	FORMATION TOPS:		
Shale-redbed-sand	550	750	SAMPLE LOG		
Redbed	750	838	Grand Haven	2374	
Anhydrite	838	874	1st Tarkio Sd	2387	
Shale & shells	874	1560	2nd Tarkio Sd	2406	
Lime & shale	1560	1720	Tarkio lime	2441	
Shale & lime	1720	2045	3rd Tarkio Sd	2484	
Lime & shale	2045	2180	Topeka	2717	2717
Shale & lime	2180	2382	Heebner	2943	2944
Core	2382	2422	Toronto	2962	2962
Shale & lime	2422	2620	Lansing	3004	3006
Shale	2620	2720	B/KC	3269	3270
Shale & lime	2720	2775	Conglomerate	3299	3300
Lime & shale	2775	3020	Quartzite	3377	3378
Lime	3020	3085	T. D.	3386	3387
Lime & shale	3085	3340	D & A		
Shale & sandy chert	3085	3380			
Granite Wash	3380	3386			
T.D.		3386			

I, the undersigned, being first duly sworn upon oath, state that this well record is true, correct and complete according to the records of this office and to the best of my knowledge and belief.

Name and title of representative of company

Subscribed and sworn to before me this 19th day of September, 1959

My Commission expires 10/11/62

Notary Public.

15-167-00117-80-20
WELL NO. 1 COUNTY RUSSELL SEC. 12 TWP. 14S RGE. 14W
FARM NAME, DRISCOLL