


STATE OF KANSAS
STATE CORPORATION COMMISSION

WELL PLUGGING RECORD

Give All Information Completely
Make Required Affidavit
Mail or Deliver Report to
Conservation Division
State Corporation Comm.
245 North Water
Wichita, KS 67202

Russell County. Sec. 29 Twp. 14 Rge. 11 E/W
Location as "NE/CNW $\frac{1}{4}$ SW $\frac{1}{4}$ " or footage from lines
SW NW NW

Lease Owner Frank W. Vishnefske
Lease Name Herber Well No. 2
Office Address 119 South Santa Fe, Salina, Kansas 67401
Character of Well (Completed as Oil, Gas or Dry Hole)

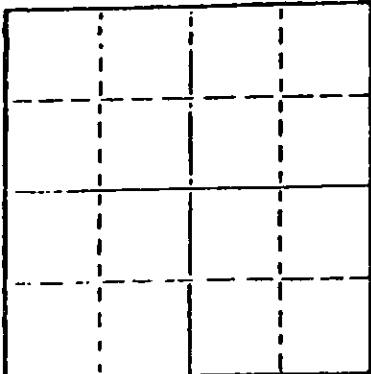

Locate well correctly on above
Section Plat

Dry Hole
Date Well completed 12-20 19 78
Application for plugging filed 12-20 19 78
Application for plugging approved 12-20 19 78
Plugging commenced 12-20 19 78
Plugging completed 12-20 19 78
Reason for abandonment of well or producing formation
Dry Hole

If a producing well is abandoned, date of last production
19

Was permission obtained from the Conservation Division or
its agents before plugging was commenced? Yes

Name of Conservation Agent who supervised plugging of this well Duane Rankin
Producing formation Depth to top Bottom Total Depth of Well 2,855
Show depth and thickness of all water, oil and gas formations.

OIL, GAS OR WATER RECORDS

CASING RECORD

FORMATION	CONTENT	FROM	TO	SIZE	PUT IN	PULLED OUT
				8 5/8"	223'	Cmtd w/165 sax

Describe in detail the manner in which the well was plugged, indicating where the mud fluid
was placed and the method or methods used in introducing it into the hold. If cement or other
plugs were used, state the character of same and depth placed, from _____ feet to
_____ feet for each plug set.

- Fill hole w/heavy mud
- Push bridge plug to 420'
- Spot 50 sax cement on plug thru 4 1/2" drill pipe
- Push bridge plug to 210'
- Spot 25 sax cement on plug thru 4 1/2" drill pipe
- Push bridge plug to 40' w/ 1/2 sax hulls on plug
- Dump 10 sax cement on plug to cellar
- Dump 3 sax cement in rat hole
- Dump 2 sax cement in mouse hole

(If additional description is necessary, use BACK of this sheet)

Name of Plugging Contractor Shields Drilling Co., Inc. Shields Bldg., Russell, Kansas 67665

STATE OF Kansas COUNTY OF Russell, ss. contractor
R. L. Shields (employee of owner) or (owner or operator)
of the above-described well, being first duly sworn on oath, says: That I have knowledge of
the facts, statements, and matters herein contained and the log of the above-described well
as filed and that the same are true and correct. So help me God.

(Signature) R. L. Shields
Shields Bldg., Russell, Kansas
(Address)

SUBSCRIBED AND SWORN TO before me this 26th day of December, 19 78

My commission expires May 26, 1979

Ruth Phillips
Notary Public.



Shields


15-167-21272-00-00

Russell, Kansas

WELL LOG

Operator: Frank W. Vishnefske
 Well: Herber #2
 Commenced: December 14, 1978
 Completed: December 21, 1978
 Contractor: Shields Drilling Co., Inc.

Well Description: SW NW NW
 Sec. 29-14S-11W
 Russell Co., Kansas

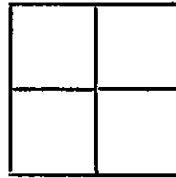

CASING RECORD

Size	Run	Pulled
8 5/8"	223'	Cmtd w/165 sax

Elevation:
 Treatment:
 Production:
 Tops:

..... Figures Indicate Bottom of Formations

Sand	40'
Shale & redbed	228'
Redbed	526'
Anhydrite	556'
Redbed	1,247'
Shale & shells	1,470'
Shale & lime	2,342'
Lime	2,564'
Lime & shale	2,672'
Lime	2,855'

Notes