


STATE OF KANSAS
STATE CORPORATION COMMISSION

WELL PLUGGING RECORD

Give All Information Completely
Make Required Affidavit
Mail or Deliver Report to
Conservation Division
State Corporation Comm.
245 North Water
Wichita, KS 67202

Russell County, Sec. 27 Twp. 14S Rge. 11W E/W
Location as "NE/CNW $\frac{1}{4}$ SW $\frac{1}{4}$ " or footage from lines
NE/4 NW/4 NW/4

Lease Owner Saline Basin Petroleum Company
Lease Name Beisel Well No. B-1
Office Address 119 South Santa Fe, Salina, Kansas 67401
Character of Well (Completed as Oil, Gas or Dry Hole)

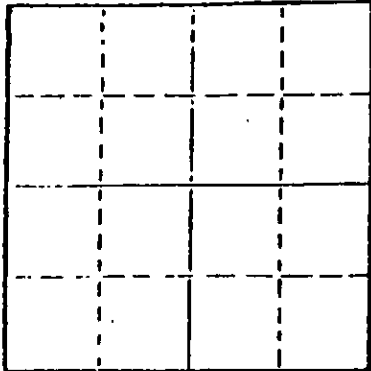

Locate well correctly on above
Section Plot

D & A
Date Well completed December 11, 1979
Application for plugging filed December 11, 1979
Application for plugging approved December 11, 1979
Plugging commenced December 12, 1979
Plugging completed December 12, 1979
Reason for abandonment of well or producing formation
D & A

If a producing well is abandoned, date of last production 19__

Was permission obtained from the Conservation Division or
its agents before plugging was commenced? Yes

Name of Conservation Agent who supervised plugging of this well Duane L. Rankin
Producing formation _____ Depth to top _____ Bottom _____ Total Depth of Well 2,890'
Show depth and thickness of all water, oil and gas formations.

OIL, GAS OR WATER RECORDS

CASING RECORD

FORMATION	CONTENT	FROM	TO	SIZE	PUT IN	PULLED OUT
				8 5/8"	221.74'	-0-

Describe in detail the manner in which the well was plugged, indicating where the mud fluid
was placed and the method, or methods used in introducing it into the hold. If cement or other
plugs were used, state the character of same and depth placed, from _____ feet to
_____ feet for each plug set.

- 1st Plug @ 450' w/50 sx cement
- 2nd Plug @ 210' w/25 sx cement
- 3rd Plug @ 40' w/1/2 sx hulls & 10 sx cement
- 5 sx cement in rathole
- 50-50 Pozmix, 4% Gel

(If additional description is necessary, use BACK of this sheet)


Name of Plugging Contractor Red Tiger Drilling Company
1720 KSB&T Building, Wichita, Kansas 67202

STATE OF Kansas COUNTY OF Sedgwick, ss. contractor
Gloria Fawcett (employee of ~~xxxxxxx~~)
of the above-described well, being first duly sworn on oath, says: That I have knowledge of
the facts, statements, and matters herein contained and the log of the above-described well
as filed and that the same are true and correct. So help me God.

(Signature) Gloria Fawcett
1720 KSB&T Building, Wichita, Kansas 67202
(Address)

SUBSCRIBED AND SWORN TO before me this 17th day of December, 1979.

My commission expires

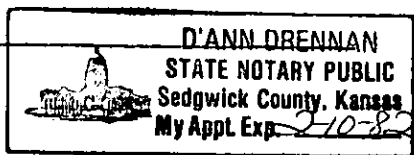

DEC 20 1979

CONSERVATION DIVISION
Wichita, Kansas

DRILLERS LOG

No. 5 Beisel

CASING RECORD:	COMPANY: Saline Basin Petroleum Company	DESCRIPTION:
8 5/8" @ 229' w/145 sx cement	CONTRACTOR: Red Tiger Drilling Company	NE/4 NW/4 NW/4 Sec. 27-T14S-R11W Russell County, Kansas
D & A	COMMENCED: December 6, 1979	
	COMPLETED: December 12, 1979	
TOTAL DEPTH: 2,890'		ELEVATION: 1,666' KB (Est.)

<u>FORMATION</u>	<u>FROM</u>	<u>TO</u>	<u>REMARKS</u>
Soil & Sand	0	45	
Shale, Sand & Hard Sand Streaks	45	232	
Shale & Sand Streaks	232	360	
Shale	360	420	
Red Bed	420	534	
Anhydrite	534	565	
Shale	565	1180	
Shale & Lime	1180	1398	
Lime & Shale	1398	2478	
Lime	2478	2890	
RTD		2890	

I certify that this is a true and correct copy of the above log to the best of my knowledge.

RED TIGER DRILLING COMPANY

Gloria Fawcett
Gloria Fawcett

Subscribed and sworn to before me this 17th day of December, 1979.

D'Ann Drennan
Notary Public

