

15-167-20909-00-00

STATE OF KANSAS  
STATE CORPORATION COMMISSION  
CONSERVATION DIVISION  
P. O. BOX 17027  
WICHITA, KANSAS 67217

FORM CP-4

WELL PLUGGING RECORD

Russell County, Sec. 27 Twp. 14 Rge. 11 (E) W (W)

Location as "NE/CNW/SW" or footage from lines SW SE NW

Lease Owner Frank W. Vishnefske

Lease Name Beisel Well No. 3

Office Address 119 South Santa Fe, Salina, Kansas 67401

Character of Well (completed as Oil, Gas or Dry Hole) Dry hole

Date well completed 6-3 1976

Application for plugging filed 6-3 1976

Application for plugging approved 6-3 1976


Plugging commenced 6-3 1976

Plugging completed 6-3 1976

Reason for abandonment of well or producing formation Dry hole

If a producing well is abandoned, date of last production 19

Was permission obtained from the Conservation Division or its agents before plugging was commenced? Yes

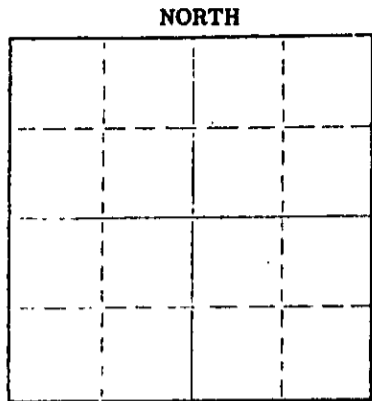

Locate well correctly on above Section Plot

Name of Conservation Agent who supervised plugging of this well

Producing formation Depth to top Bottom Total Depth of Well 2,884 Feet

Show depth and thickness of all water, oil and gas formations.

OIL, GAS OR WATER RECORDS

CASING RECORD

FORMATION	CONTENT	FROM	TO	SIZE	PUT IN	PULLED OUT
				8 5/8"	215'	Cmtd. w/170 sax

Describe in detail the manner in which the well was plugged, indicating where the mud fluid was placed and the method or methods used in introducing it into the hole. If cement or other plugs were used, state the character of same and depth placed, from feet to feet for each plug set.

- Fill hole w/heavy mud
- Push bridge plug to 420'
- Spot 50 sax cement on plug thru 4 1/2" drill pipe
- Fill hole w/heavy mud
- Push bridge plug to 220'
- Spot 25 sax cement on plug thru 4 1/2" drill pipe
- Fill hole w/heavy mud
- Push bridge plug to 40' w/1/2 sax hulls on plug
- Dump 10 sax cement on plug to cellar; Dump 2 sax cement in rat hole

Name of Plugging Contractor Shields Drilling Co., Inc.  
Address Shields Bldg., Russell, Kansas 67665

STATE OF KANSAS COUNTY OF RUSSELL contractor R.L. Shields (employee of owner) or (operator) of the above-described well.

being first duly sworn on oath, says: That I have knowledge of the facts, statements, and matters herein contained and the log of the above-described well as filed and that the same are true and correct. So help me God.

(Signature) R.L. Shields Shields Bldg., Russell, Kansas (Address)

Subscribed and sworn to before me this 18th day of June 1976

My commission expires May 26, 1979 Notary Public.



Shields


15-167-20909-00-00

Russell, Kansas

WELL LOG

Operator: Frank W. Vishnefske  
 Well: Beisel #3  
 Commenced: May 28, 1976  
 Completed: June 3, 1976  
 Contractor: Shields Drilling Co., Inc.

Well Description: SW SE NW  
 Sec. 27-14S-11W  
 Russell Co., Kansas

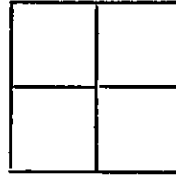

CASING RECORD

Size	Run	Pulled
8 5/8"	215'	Cmtd. w/170 sax

Elevation: 1,662' RB

Treatment:

Production: D & A

Tops:

..... Figures Indicate Bottom of Formations .....

Sand & clay	222'	
Shale & shells	317'	
Sand & redbed	521'	
Anhydrite	550'	
Shale & shells	1,100'	
Lime & shale	2,688'	
Lime	2,884'	RTD

SHIELDS DRILLING CO., INC.  
 RUSSELL, KANSAS

Notes