

15-167-20278-00-00

STATE OF KANSAS  
STATE CORPORATION COMMISSION


Give All Information Completely  
Make Required Affidavit  
Mail or Deliver Report to:  
Conservation Division  
State Corporation Commission  
212 No. Market  
Wichita, Kansas

WELL PLUGGING RECORD

Russell County, Sec. 26 Twp. 14 Rge. (E) 11(W)

Location as "NE/CNW&SW¼" or footage from lines C E/2 NW NW  
Lease Owner Saline Basin Petroleum Company  
Lease Name Small Well No. 1  
Office Address 119 S. Santa Fe, Salina, Kansas  
Character of Well (completed as Oil, Gas or Dry Hole) dry hole  
Date well completed 1-17-69 19 69  
Application for plugging filed 1-17-69 19  
Application for plugging approved 1-17-69 19  
Plugging commenced 1-17-69 19  
Plugging completed 1-17-69 19  
Reason for abandonment of well or producing formation Dry hole

NORTH

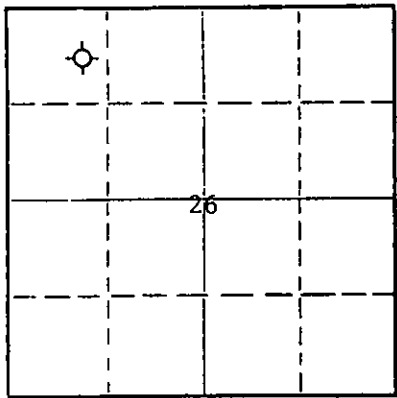

Locate well correctly on above Section Plat

If a producing well is abandoned, date of last production 19  
Was permission obtained from the Conservation Division or its agents before plugging was commenced? Yes

Name of Conservation Agent who supervised plugging of this well Don Truane  
Producing formation \_\_\_\_\_ Depth to top \_\_\_\_\_ Bottom \_\_\_\_\_ Total Depth of Well 3268 Feet  
Show depth and thickness of all water, oil and gas formations.

OIL, GAS OR WATER RECORDS

CASING RECORD

FORMATION	CONTENT	FROM	TO	SIZE	PUT IN	PULLED OUT

STATE RECEIVED  
JAN 27 1969  
CONSERVATION DIVISION  
Wichita, Kansas

Describe in detail the manner in which the well was plugged, indicating where the mud fluid was placed and the method or methods used in introducing it into the hole. If cement or other plugs were used, state the character of same and depth placed, from \_\_\_\_\_ feet to \_\_\_\_\_ feet for each plug set.

Filled hole to 370 feet with heavy mud. Set plug and ¼ sack rolled tied hulls at 370 feet. Cemented hole with 25 sacks through drill pipe. Filled hole to 240 feet with heavy mud. Set plug at 240 feet. Cemented hole with 25 sacks through drill pipe. Filled hole to 40 feet with heavy mud. Dumped ½ sacks hulls on fluid at 40 feet. Dumped ½ sack dry cement on hulls. Pushed ¼ sack hulls rolled and tied on top of bridge. Cemented top of hole with 10 sacks cement. Bridge rat hole and cemented with two sacks cement three feet below ground level.

(If additional description is necessary, use BACK of this sheet)

Name of Plugging Contractor American Drilling Co., Ltd.  
Address 550 Sutton Place, Wichita, Kansas

STATE OF Kansas, COUNTY OF Sedgwick, ss.  
Larry G. Stephenson (employee of owner) or (owner or operator) of the above-described well, being first duly sworn on oath, says: That I have knowledge of the facts, statements, and matters herein contained and the log of the above-described well as filed and that the same are true and correct. So help me God.

(Signature) Larry G. Stephenson  
550 Sutton Place, Wichita, Kansas  
(Address)

SUBSCRIBED AND SWORN TO before me this 20th day of January, 19 69

Margie Stephenson  
Notary Public.

My Commission Expires July 25, 1972  
My commission expires \_\_\_\_\_

15-187-20278-00-00

COMPANY: Saline Basin Petroleum Company  
CONTRACTOR: American Drilling Co., Ltd.  
FARM: Small #1  
LOCATION: Section 26-14-11W, Russell County  
C E/2 NW NW  
COMMENCED: January 10, 1969  
COMPLETED: January 17, 1969

---

0	to	264	Shale
264	to	275	Iron Pyrite
275	to	332	Shale & Sand
332	to	340	Pyrite
340	to	483	Shale & Shells
483	to	527	Shale
527	to	558	Anhydrite
558	to	1225	Shale
1225	to	1365	Lime
1365	to	2655	Shale & Lime
2655	to	3140	Lime
3140	to	3160	Lime & Chert
3160	to	3268	Lime

RECEIVED  
STATE CORPORATION COMMISSION  
JAN 27 1969  
CONSERVATION DIVISION  
Wichita, Kansas

---

Set 264 feet of 8 5/8" surface pipe w/180 sacks common cement

Dry and Abandoned

---

CERTIFICATE

I, Larry G. Stephenson, do hereby certify that the above and foregoing is a true and correct copy of the drillers log of the Small #1, Section 26-14-11W, Russell County, Kansas as reflected by files of the American Drilling Co., Ltd.

  
Larry G. Stephenson