AFFIDAVIT OF COMPLETION FORM ACO-1 WELL HISTORY

Compt.____

SIDE ONE

(Rules 82-3-130 and 82-3-107) DOCKET NO. NP_____

This form shall be filed with the Kansas Corporation Commission, 200 Colorado Derby Building, Wichita, Kansas 67202, within ninety (90) days after the completion of a well, regardless of how the well was completed.

FOR INFORMATION REGARDING THE NUMBER OF COPIES TO BE FILED AND APPLICATIONS REQUIRING COPIES OF ACO-1 FORMS SEE PAGE TWO (2), SIDE TWO (2) OF THIS FORM.

(F) ✓ Letter requesting confidentiality attached.

(C) ✓ Attach ONE COPY of EACH wireline log run (i.e. electrical log, sonic log, gamma ray neutron log etc.)***Check here if NO logs were run_____.

PLEASE FILL IN ALL INFORMATION. IF NOT AVAILABLE, INDICATE. IF INFORMATION LATER BECOMES AVAILABLE, SUBMIT BY LETTER.

LICENSE # 8775 EXPIRATION DATE 7-1-84

OPERATOR Star II Oil Company API NO. 15-051-23,541-00-00

ADDRESS Box 56 COUNTY Ellis

Victoria, Kansas 67671 FIELD _____

** CONTACT PERSON Herman Weber PROD. FORMATION _____

PHONE 913-735-2561 _____ Indicate if new pay.

PURCHASER _____ LEASE Brungardt

ADDRESS _____ WELL NO. B-1

_____ WELL LOCATION N/2 NW NW NE

DRILLING CONTRACTOR Allen Drilling Company _____ Ft. from _____ Line and

_____ Ft. from _____ Line of

ADDRESS Box 1389 the NE (Qtr.) SEC 12 TWP 14 RGE 17 (W).

Great Bend, Kansas 67530

PLUGGING CONTRACTOR Allen Drilling Company

ADDRESS Box 1389

Great Bend, Kansas 67530

WELL PLAT

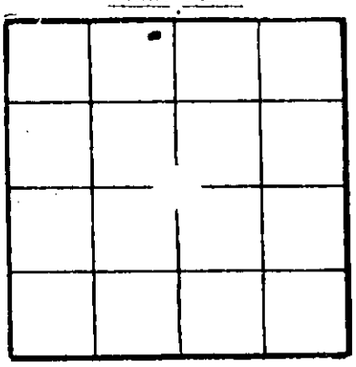

(Office Use Only)

KCC ✓

KGS ✓

SWD/REP__

PLG.____

NGPA____

TOTAL DEPTH 3550' PBTD _____

SPUD DATE 7-18-83 DATE COMPLETED 7-24-83

ELEV: GR 1916' DF 1918' KB 1921'

DRILLED WITH (~~CABLE~~) (ROTARY) (~~AIR~~) TOOLS.

DOCKET NO. OF DISPOSAL OR REPRESSURING WELL BEING USED TO DISPOSE OF WATER FROM THIS LEASE _____.

Amount of surface pipe set and cemented 245' DV Tool Used? _____.

TYPE OF COMPLETION THIS AFFIDAVIT APPLIES TO: (Circle ONE) - Oil, Shut-in Gas, Gas, (Dry) Disposal, Injection, Temporarily Abandoned. If OWWO, indicate type of re-completion _____. Other completion _____. NGPA filing _____.

ALL REQUIREMENTS OF THE STATUTES, RULES AND REGULATIONS PROMULGATED TO REGULATE THE OIL AND GAS INDUSTRY HAVE BEEN FULLY COMPLIED WITH.

A F F I D A V I T

HERMAN V. WEBER, being of lawful age, hereby certifies that:

I am the Affiant, and I am familiar with the contents of the foregoing Affidavit. The statements and allegations contained therein are true and correct.

Herman V. Weber
(Name)

SUBSCRIBED AND SWORN TO BEFORE ME this 5 day of Aug, 19 83.

A.F. BASGALL
NOTARY PUBLIC
State of Kansas
My Appointment Expires:

A. F. Basgall
(NOTARY PUBLIC)

MY COMMISSION EXPIRES: 3 Mar 1986

RECEIVED
STATE CORPORATION COMMISSION

** The person who can be reached by phone regarding any questions concerning this information.

AUG 08 1983

CONSERVATION DIVISION
Wichita, Kansas

08-09-1983