


Give All Information Completely
Make Required Affidavit
Mail or Deliver Report to:
Conservation Division
State Corporation Commission
500 Hitting Building
Wichita, Kansas

OR

FORMATION PLUGGING RECORD

Strike out upper line
when reporting plugging
of formations.

Saline County. Sec. 17 Twp. 14S Rge. 3W (W)
Location as "NE $\frac{1}{4}$ NW $\frac{1}{4}$ SW $\frac{1}{4}$ " or footage from lines. SE/4 SE/4
Lease Owner. Dulah W. Geary
Lease Name. Bell Well No. 1
Office Address. 1350 Brant Street, Denver, Colorado
Character of Well (completed as Oil, Gas or Dry Hole). Dry hole
Date well completed. June 23 19. 46
Application for plugging filed. June 23 19. 46
Application for plugging approved. June 23 19. 46
Plugging commenced. June 23 19. 46
Plugging completed. June 23 19. 46
Reason for abandonment of well or producing formation. Dry

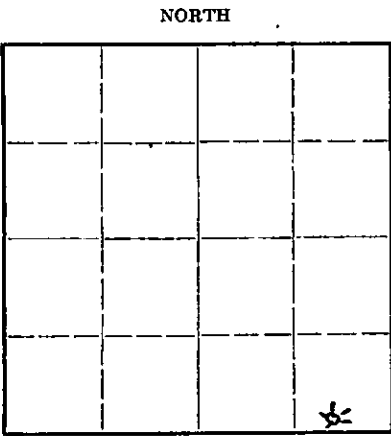

Locate well correctly on above
Section Flat

If a producing well is abandoned, date of last production. 19.
Was permission obtained from the Conservation Division or its agents before plugging was commenced? yes--oral

Name of Conservation Agent who supervised plugging of this well. Ruel Durkee
Producing formation. Depth to top. Bottom. Total Depth of Well. 376.5 Feet
Show depth and thickness of all water, oil and gas formations.


OIL, GAS OR WATER RECORDS

CASING RECORD

Formation	Content	From	To	Size	Put In	Pulled Out
				12 1/2"	167'	
				8 5/8"	312'	none

Describe in detail the manner in which the well was plugged, indicating where the mud fluid was placed and the method or methods used in introducing it into the hold. If cement or other plugs were used, state the character of same and depth placed, from... feet to... feet for each plug set.

Filed hole full mud to within 312 feet of top. Drove wooden plug to 312' of top and bridged, dumped in 20 sacks cement. Finished filling hole full heavy mud to within 15 ft. of top and put in 10 sacks cement.

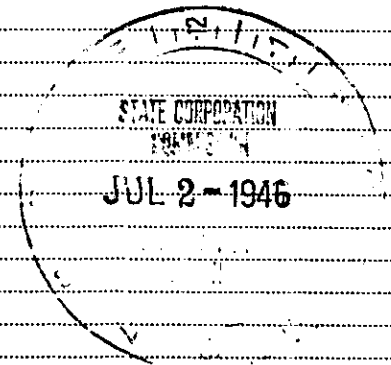

FILE 17 14 3W
58 39

(If additional description is necessary, use BACK of this sheet)
Correspondence regarding this well should be addressed to. C. C. Nelson Drilling Company
Address. 1023 Union National Bank Bldg. Wichita, Kansas

STATE OF Kansas, COUNTY OF Sedgwick
C. C. Nelson --Agent (employee of owner) or (owner or operator) of the above-described well,

being first duly sworn on oath, says: That I have knowledge of the facts, statements, and matters herein contained and the log of the above-described well as filed and that the same are true and correct. So help me God.

(Signature) C. C. Nelson

SUBSCRIBED AND SWORN to before me this 1st day of July, 1946
Notary Public. Esther Small

My commission expires May 25, 1949

COMPANY: Dulah W. Geary
 CONTRACTOR: C. C. Nelson Drilling Company
 FARM: Beil #1
 LOCATION: SE/4 SE/4 Sec. 17-14S-3W
 Saline County, Kansas
 COMMENCED: June 4, 1946
 COMPLETED: June 23, 1946

0	to	130	Surface hole
130	to	235	Lime and shale
235	to	615	Lime and shale
615	to	640	Lime
640	to	760	Sandy lime
760	to	865	Lime
865	to	1180	Shale and lime
1180	to	1440	Shale and shells
1440	to	1645	Shale and lime
1645	to	1780	Shale and shells
1780	to	1970	Lime
1970	to	2410	Lime and shale
2410	to	2598	Lime
2598	to	2914	Shale and lime
2914	to	3040	Lime and chert
3040	to	3149	Lime
3149	to	3167	Chert and lime
3167	to	3483	Lime
3483	to	3540	Shale and lime
3540	to	3580	Lime
3580	to	3765	Lime
		3765	T.D.

616

C E R T I F I C A T E

Set 167 ft. of 12 1/2" surface pipe. Cemented with 110 sacks cement.
 Set 312 ft. of 8 5/8" surface pipe. Cemented with 140 sacks cement.

Top Lansing	2250	Top Simpson	3663
Top Mississippi	2918	Top Arbuckle	3749
Top Hunton	3375		
Top Viola	3560		

17 14 130
 58 39

DRY, ABANDONED AND PLUGGED

I, C. C. Nelson, do hereby certify that the above and foregoing is a true and correct copy of log of the Beil #1, SE/4 SE/4, Sec. 17-14S-3W, Saline County Kansas, as reflected by files of the Nelson Drilling Company.

C. C. Nelson

Subscribed and sworn to before me a Notary Public of Sedgwick County, Kansas, this 29 day of June 1946.

Ether Russell

My commission expires May 25 1949