


15-169-00088-00-00

STATE OF KANSAS
STATE CORPORATION COMMISSION

WELL PLUGGING RECORD

Give All Information Completely
Make Required Affidavit
Mail or Deliver Report to:
Conservation Division
State Corporation Commission
800 Bitting Building
Wichita, Kansas

NORTH

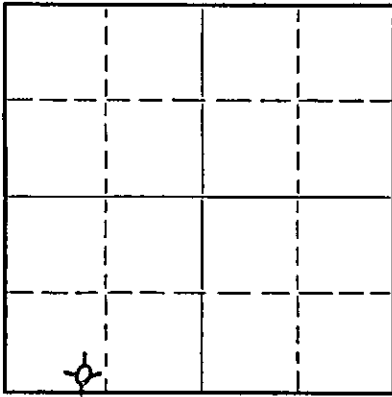

Locate well correctly on above
Section Plat

Saline County, Sec. 34 Twp. 14 Rge. 4 W (E) (W)
Location as "NE/CNW $\frac{1}{4}$ SW $\frac{1}{4}$ " or footage from lines SE/ $\frac{1}{4}$ SW/ $\frac{1}{4}$ SW/ $\frac{1}{4}$
Lease Owner F. W. Vishnefske
Lease Name McCormick Well No. #1
Office Address 119 So. Santa Fe; Salina, Kansas
Character of Well (completed as Oil, Gas or Dry Hole) Dry Hole
Date well completed October 5 1951
Application for plugging filed October 5 1951
Application for plugging approved October 8 1951
Plugging commenced October 5 1951
Plugging completed October 5 1951
Reason for abandonment of well or producing formation No Production

If a producing well is abandoned, date of last production 19...
Was permission obtained from the Conservation Division or its agents before plugging was commenced? Yes

Name of Conservation Agent who supervised plugging of this well Ruel Durkee, S.C.C.
Producing formation Viola Depth to top 363 $\frac{1}{2}$ Bottom 3640 Total Depth of Well 3696 Feet
Show depth and thickness of all water, oil and gas formations.

OIL, GAS OR WATER RECORDS

CASING RECORD

Formation	Content	From	To	Size	Put In	Pulled Out

Describe in detail the manner in which the well was plugged, indicating where the mud fluid was placed and the method or methods used in introducing it into the hole. If cement or other plugs were used, state the character of same and depth placed, from... feet to ... feet for each plug set.

As no shows of oil or gas in commercial quantities were encountered, the hole was plugged under the supervision of Ruel Durkee, S.C.C. well plugger as follows:

Set Plug at 160 feet
Cemented with 15 Sacks of Cement
Filled hole to 20 feet with mud
Set plug at 20 feet
Cemented with 5 Sacks of Cement
Filled hole to 6 feet with mud
Surface soil from 6 feet to top

(If additional description is necessary, use BACK of this sheet)

Correspondence regarding this well should be addressed to F. W. Vishnefske
Address 119 South Santa Fe; Salina, Kansas

STATE OF Kansas, COUNTY OF Saline, ss.
F. W. Vishnefske (employee of owner) or (owner or operator) of the above-described well,
being first duly sworn on oath, says: That I have knowledge of the facts, statements, and matters herein contained and the log of the above-described well as filed and that the same are true and correct. So help me God.

10-25-51 (Signature) F.W. Vishnefske
119 South Santa Fe; Salina, Kansas (Address)

SUBSCRIBED AND SWORN to before me this 24th day of October, 1951.

Ethel D. Johnson
Notary Public.

My commission expires March 15, 1955

23-5091-5 8-50-10M

PLUGGING
FILE 114-14-42
BOOK 114-14-29

15-169-00088 -00-00

WELL RECORD

LEASE NAME McCormick WELL NO. 1

LOCATION SE/4 SW/4 SW/4 Section 34-14S-14W, Saline County, Kansas

WORK COMMENCED August 14, 1951 DRILLING COMMENCED September 18, 1951

DRILLING COMPLETED October 8, 1951

DRILLING CONTRACTOR J. A. Melland, Hutchinson, Kansas

ROTARY DRILLING FROM 0 TO 3696'

OWNER F. W. Vishnefske, Salina, Kansas

FORMATION	FROM	TO	REMARKS
Shale and shells	0	135	
Shale and salt	135	360	
Shale, shells and Anhydrite	360	360	
Shale and Anhydrite	360	375	Set & cemented 8-5/8" OD casing at 375' w/ 250 sacks of cement, 3 sacks of calcium chloride and 100# of Floccs. Cement circulated.
Lime and shale	375	2234	Circulated at 2105' 1 hour. Circulated at 2155' 1 hour. Circulated at 2165' 4 hours & 48 min. Circulated at 2210' 34 minutes.
Shale and sand	2234	2325	
Shale and lime	2325	2425	Top Kansas City Lime 2394'.
Lime and shale	2425	2525	Circulated at 2364' 34 minutes.
Lime	2525	2615	Circulated at 2416' 35 minutes. Circulated at 2425' 38 minutes. Circulated at 2478' 1 hour & 16 mins. Circulated at 2497' 15 minutes.
Lime and shale	2615	3050	Circulated at 2567' 36 minutes. Circulated at 2815' 30 minutes. Circulated at 2838' 1 hour & 6 mins. Circulated at 2930' 52 minutes. Circulated at 2958' 1 hour Circulated at 2986' 2 hours & 12 mins. Circulated at 3014' 57 minutes.
Lime	3050	3135	Top Mississippi Lime 3057' Circulated at 3060' 1 hour & 6 mins. Circulated at 3099' 1 hour.
Cherty lime	3135	3190	
Lime and Cherty lime	3190	3240	
Lime	3240	3300	Top Maquoketa 3300'.
Cherty lime	3300	3330	
Lime and Cherty lime	3330	3355	
Lime and shale	3355	3370	
Shale and lime	3370	3435	
Shale	3435	3510	Top Wisner 3497'. Top Hunter 3509'.
Lime and shale	3510	3645	Circulated at 3508' 41 minutes. Circulated at 3512' 24 minutes. Circulated at 3615' 1 hour & 25 mins. Circulated at 3630' 1 hour. Circulated at 3636' 1 hour & 33 mins. Circulated at 3637' 1 hour & 30 mins. Randrill stem test, open 1 hour, recovered 150' of salt water.
Lime	3645	3696	Circulated at 3640' 2 hours & 41 mins. TOTAL DEPTH Slope tests were taken at regular intervals and no deflections from vertical were recorded.

As no shows of oil or gas in commercial quantities were encountered, the hole was plugged under the supervision of Druel Durkee, S.C.C. well plugger as follows:

STATE CORPORATION COMMISSION

OCT 25 1951

CONSERVATION DIVISION
PLUGGING

F.W. Vishnefske
Salina, Kansas

FILE SEC 24 | 14 | R 44
BOOK PAGE 14 | LINE 24

Set plug at 160'
Cemented w/ 15 sacks of cement
Filled hole to 20' w/ mud
Set plug at 20'
Cemented w/ 5 sacks of cement
Filled hole to 6' w/ mud
Surface soil from 6' to top