

15-169-00038-00-00

STATE OF KANSAS  
STATE CORPORATION COMMISSION

WELL PLUGGING RECORD


FORMATION PLUGGING RECORD

Give All Information Completely  
Make Required Affidavit  
Mail or Deliver Report to:  
Conservation Division  
State Corporation Commission  
800 Bitting Building  
Wichita, Kansas

OR

Strike out upper line  
when reporting plugging  
off formations.

NORTH

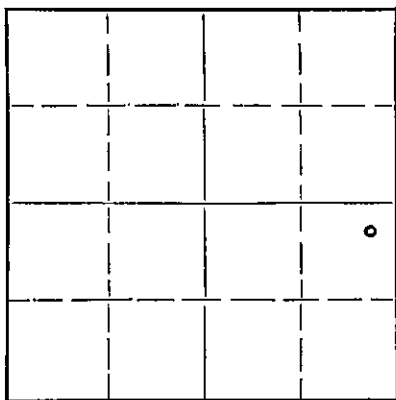

Locate well correctly on above  
Section Plat

Saline County. Sec 11 Twp 14 Rge 4 (E) W (W)  
Location as "NE 1/4 NW 1/4 SW 1/4" or footage from lines NE/4 NE/4 SE/4  
Lease Owner C. U. Bay  
Lease Name R. B. Johnson Well No. 1  
Office Address 1006 Brown Bldg., Wichita 2, Kansas  
Character of Well (completed as Oil, Gas or Dry Hole) Dry Hole  
Date well completed August 25 1954  
Application for plugging filed August 25 1954  
Application for plugging approved August 25 1954  
Plugging commenced August 25 1954  
Plugging completed August 26 1954  
Reason for abandonment of well or producing formation Dry Hole

If a producing well is abandoned, date of last production 19  
Was permission obtained from the Conservation Division or its agents before plugging was commenced? Yes

Name of Conservation Agent who supervised plugging of this well  
Producing formation Depth to top Bottom Total Depth of Well 3807 Feet  
Show depth and thickness of all water, oil and gas formations.

OIL, GAS OR WATER RECORDS

CASING RECORD

Formation	Content	From	To	Size	Put In	Pulled Out
				8.5/8"	370'	Cemented

Describe in detail the manner in which the well was plugged, indicating where the mud fluid was placed and the method or methods used in introducing it into the hole. If cement or other plugs were used, state the character of same and depth placed, from feet to feet for each plug set.

Filled hole with mud to 190'  
Bridging plug @ 190'  
Cemented with 15 sax  
Mud to 25'  
Bridging plug @ 25'  
Cemented with 5 sax to bottom of cellar  
Mud to surface

08-30-54

(If additional description is necessary, use BACK of this sheet)

Correspondence regarding this well should be addressed to C. U. Bay  
Address 1006 Brown Building, Wichita 2, Kansas

STATE OF Kansas, COUNTY OF Russell, ss.  
R. J. Shields (employee of owner) or (owner or operator) of the above-described well,

being first duly sworn on oath, says: That I have knowledge of the facts, statements, and matters herein contained and the log of the above-described well as filed and that the same are true and correct. So help me God.

(Signature) [Signature]  
839 Main, Russell, Kansas (Address)

SUBSCRIBED AND SWORN to before me this 28th day of August, 1954

[Signature] Notary Public.

My commission expires 12-18-57

PLUGGING  
FILE SEC 11 T 14 R 4W  
BOOK PAGE 60 LINE 5

15-169-00038-00-00

WELL LOG

C. U. Bay  
R. B. Johnson #1

NE NE SE  
Sec. 11, Twp. 14, Rge. 4W  
Saline County, Kansas

Total Depth: 3807'  
Commenced: August 8, 1954  
Completed: August 26, 1954  
Drilled by Shields Drig. Co., Inc.

CASING RECORD

Size 8 5/8" Run 370' Cemented Cmtd with 275 sac Elevation: 1252 RB  
Treatment: None  
Production: D&A

-----Figures Indicate Bottom of Formation-----

Top Soil	15
Shale & Sand Streaks	50
Shale	118
Shale & Lime	360
Shale	364
Anhydrite Lime	385
Lime & Shale	555
Red Bed & Shale	570
Shale	805
Lime & Shale	1130
Shells & Shale	1240
Lime & Shale	1270
Salt & Shale	1290
Shale & Shells	1465
Shale & Lime	1760
Lime & Shale	2168
Shale & Lime	2260
Lime & Shale	2785
Shale	2938
Lime & Shale	2976
Shale & Lime	3025
Lime	3135
Lime & Shale	3189
Lime	3244
Lime & Shale	3270
Shale	3397
Lime & Shale	3511
Shale	3567
Shale & Lime	3618
Lime & Shale	3657
Shale	3677
Shale & Lime	3702
Lime & Shale	3749
Shale	3803
Arbuckle	3807 TD

PLUGGING  
FILE SEC 11 T 14 R 4W  
BOOK PAGE 60 LINE 5