


Give All Information Completely
Make Required Affidavit
Mail or Deliver Report to:
Conservation Division
State Corporation Commission
800 Bittling Building
Wichita, Kansas

15-051-20075-00-01

WELL PLUGGING RECORD

NORTH

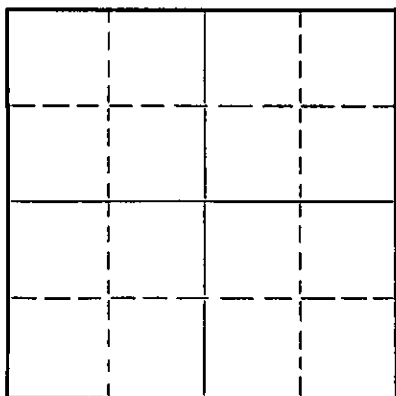

Locate well correctly on above
Section Plat

Ellis County, Sec. 25 Twp. 14S Rge. 17W (E) (W)
Location as "NE/CNW $\frac{1}{4}$ SW $\frac{1}{4}$ " or footage from lines NE NW NW
Lease Owner Bachus Oil Company
Lease Name Ruder Well No. 1
Office Address 721 E. Central, Wichita, Kansas
Character of Well (completed as Oil, Gas or Dry Hole) Dry Hole
Date well completed 1/16/70 19
Application for plugging filed 1/16/70 19
Application for plugging approved 1/16/70 19
Plugging commenced 1/16/70 19
Plugging completed 1/16/70 @ 4:30 AM 19
Reason for abandonment of well or producing formation Dry

If a producing well is abandoned, date of last production 19
Was permission obtained from the Conservation Division or its agents before plugging was commenced? Yes

Name of Conservation Agent who supervised plugging of this well Leo Massey
Producing formation Depth to top Bottom Total Depth of Well 3499 Feet
Show depth and thickness of all water, oil and gas formations.

OIL, GAS OR WATER RECORDS

CASING RECORD

Formation	Content	From	To	Size	Put In	Pulled Out
		0	190	8 5/8"	190	-0-
This casing was installed by Hummon Oil Company when the well was originally drilled to a depth of 2113						

Describe in detail the manner in which the well was plugged, indicating where the mud fluid was placed and the method or methods used in introducing it into the hole. If cement or other plugs were used, state the character of same and depth placed, from feet to feet for each plug set.

Plug to 540' with mud
70 sacks of cement through drill pipe at 540'
20 sacks of cement through drill pipe at 210'
Set a bridge that will hold kelly at 40'
10 sacks to top of surface pipe

RECEIVED
STATE CORPORATION COMMISSION

JAN 26 1970

CONSERVATION DIVISION
Wichita, Kansas

01-26-1970

(If additional description is necessary, use BACK of this sheet)

Correspondence regarding this well should be addressed to Bachus Oil Company
Address 721 E. Central, Wichita, Kansas

STATE OF Kansas, COUNTY OF Sedgwick, ss.
D. Bachus

(employee of owner) or (owner or operator) of the above-described well,
being first duly sworn on oath, says: That I have knowledge of the facts, statements and matters herein contained and the log of the above-described well as filed and that the same are true and correct. So help me God.

(Signature)

721 E. Central, Wichita, Kansas
(Address)

before me this 23rd day of January, 1970.



January 26, 1973

Nelson R. Thomas

Notary Public.

15-051-20075-00-01

CONTRACTOR'S WELL LOG

OPERATOR:	Bachus Oil Company
CONTRACTOR:	Abercrombie Drilling, Inc.
WELL NAME:	Ruder #1
LOCATION:	NE NW NW, Sec. 25-14S-17W Ellis County, Kansas
DATE COMMENCED:	January 10, 1970
DATE COMPLETED:	January 16, 1970

0	2112	Washed down hole previously drilled by Hummon Oil Company with Burt Drilling Company, as Contractor. Completed 6-19-67.
2112	2975	Lime and Shale
2975	3460	Lime
3460	3480	Lime and Shale
3480	3499	Lime
	3499	Rotary Total Depth

DRY & ABANDONED

ELEVATION:

1943 K. B.
1941 D. F.
1935 G. L.

RECEIVED
STATE CORPORATION COMMISSION
JAN 21 1970
CONSERVATION DIVISION
Wichita, Kansas

01-21-1970

STATE OF KANSAS)
) SS
COUNTY OF SEDGWICK)

Jack K. Wharton, Abercrombie Drilling, Inc., does hereby state that the above and foregoing is a true and correct copy of the log of the RUDER #1, NE NW NW, Sec. 25-14S-17W, Ellis County, Kansas.

ABERCROMBIE DRILLING, INC.

By: Jack K. Wharton

Subscribed and sworn to before me, a Notary Public, in and for the state and county above named, as of this 19th day of January, 1970.

Sue J. McCoy
Sue J. McCoy, Notary Public

My Commission Expires:

November 12, 1973