


Give All Information Completely  
Make Required Affidavit  
Mail or Deliver Report to:  
Conservation Division  
State Corporation Commission  
212 No. Market  
Wichita, Kansas

NORTH

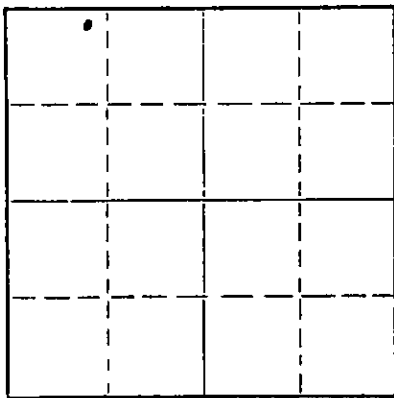

Locate well correctly on above  
Section Flat

Ellis County, Sec. 25 Twp. 14 Rge. 17 (E) (W)  
Location as "NE/CNW/SW" or footage from lines NE NW NW  
Lease Owner Hummon Oil Inc.  
Lease Name Ruder Well No. 1  
Office Address Wichita, Kansas  
Character of Well (completed as Oil, Gas or Dry Hole) Dry Hole  
Date well completed 12 June 19 67  
Application for plugging filed 12 June 19 67  
Application for plugging approved 12 June 19 67  
Plugging commenced 12 June 19 67  
Plugging completed 12 June 19 67  
Reason for abandonment of well or producing formation Dry Hole

If a producing well is abandoned, date of last production 19\_\_\_\_  
Was permission obtained from the Conservation Division or its agents before plugging was commenced? Yes

Name of Conservation Agent who supervised plugging of this well Leo Massey  
Producing formation \_\_\_\_\_ Depth to top \_\_\_\_\_ Bottom \_\_\_\_\_ Total Depth of Well 2113 Feet  
Show depth and thickness of all water, oil and gas formations.

OIL, GAS OR WATER RECORDS

CASING RECORD

FORMATION	CONTENT	FROM	TO	SIZE	PUT IN	PULLED OUT

APR 28 1967  
06-28-1967  
CONSERVATION DIVISION  
Wichita, Kansas

Describe in detail the manner in which the well was plugged, indicating where the mud fluid was placed and the method or methods used in introducing it into the hole. If cement or other plugs were used, state the character of same and depth placed, from \_\_\_\_\_ feet to \_\_\_\_\_ feet for each plug set.

Set plug and hulls and 25 sacks of cement thru drill pipe at 480'

Set plug and hulls and 25 sacks of cement thru drill pipe at 185'

Set plug and hulls and 10 sacks of cement at 40'

Put two sacks in rat hole

(If additional description is necessary, use BACK of this sheet)

Name of Plugging Contractor Burt Drilling Co.  
Address Great Bend, Kansas

STATE OF Kansas, COUNTY OF Barton, ss.  
Duke C. Burt (employee of owner) or (owner or operator) of the above-described well, being first duly sworn on oath, says: That I have knowledge of the facts, statements, and matters herein contained and the log of the above-described well as filed and that the same are true and correct. So help me God.

(Signature) *Duke C. Burt*

(Address)

SUBSCRIBED AND SWORN TO before me this 26th day of June, 19 67

My commission expires October 15, 1967

*Defton Miller*  
Notary Public.

15-051-20075-00-00

HUMMON OIL, INC.  
821 Union National Bldg.  
Wichita, Kansas.

Well: Ruder No. 1  
Commenced R. D.: 6/9/67  
Completed R. D.: 6/13/67  
Total Depth: 2113' D.F.  
Casing: 190' of 8 5/8" 24# Surface Pipe

Sec.: *NE NW NW*  
*25-14-19W*  
Ellis County, Kansas  
Elevation:  
Initial Prod.: D & A  
Contractor: BURT DRILLING  
COMPANY

Strata	Depth
Post Rock	0- 120'
Shale	120- 555
Sand	555- 710
Shale & Redbed	710-1070
Shale	1070-1079
Anhydrate	1079-1117
Shale	1117-1765
Shale & Lime	1765-1830
Lime w/Shale Streaks	1830-2113

RECEIVED  
STATE CORPORATION COMMISSION  
JUL 13 1967  
7-13-1967  
CONSERVATION DIVISION  
Wichita, Kansas

I hereby certify that the above is a true and correct log of said well as reflected by daily reports.

BURT DRILLING CO.

*Rudolph C. Burt*

Signed and sworn in my presence this 15th day of June, 1967

*Dexter Hines*

My Commission Expires: Oct. 15, 1967