


STATE OF KANSAS
STATE CORPORATION COMMISSION

Form CP-4

Give All Information Completely
Make Required Affidavit
Mail or Deliver Report to:
Conservation Division
State Corporation Commission
211 No. Broadway
Wichita, Kansas

WELL PLUGGING RECORD

NORTH

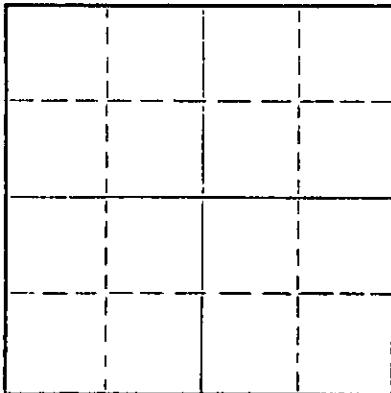

Locate well correctly on above
Section Plat

Ellis County. Sec. 19 Twp. 14S Rge. 18W (E) (W)

Location as "NE/CNW/SW" or footage from lines NE SW SW

Lease Owner J. Marshall Nye

Lease Name Befort Well No. 1

Office Address 620 Cravens Building, Oklahoma City, Okla.

Character of Well (completed as Oil, Gas or Dry Hole) dry hole

Date well completed December 19, 1966

Application for plugging filed December 18, 1966

Application for plugging approved December 18, 1966

Plugging commenced December 18, 1966

Plugging completed December 19, 1966

Reason for abandonment of well or producing formation D & A

If a producing well is abandoned, date of last production 19

Was permission obtained from the Conservation Division or its agents before plugging was commenced? yes

Name of Conservation Agent who supervised plugging of this well Eldon Petty, Hays, Kansas

Producing formation Depth to top Bottom Total Depth of Well 3775 Feet

Show depth and thickness of all water, oil and gas formations.

OIL, GAS OR WATER RECORDS

CASING RECORD

FORMATION	CONTENT	FROM	TO	SIZE	PUT IN	PULLED OUT
			242'	8 5/8"	236.19'	none

Describe in detail the manner in which the well was plugged, indicating where the mud fluid was placed and the method or methods used in introducing it into the hole. If cement or other plugs were used, state the character of same and depth placed, from feet to feet for each plug set.

Filled hole to 540' with mud and plugged with
20 sacks cement. Plug at 230' with 20 sacks
and 10 sacks at 40'.

(If additional description is necessary, use BACK of this sheet)

Name of Plugging Contractor Braden Drilling, Inc.

Address 1620 Wichita Plaza Bldg., Wichita, Kansas

STATE OF Kansas, COUNTY OF Sedgwick, ss.

James Tasheff (employee of owner) or (owner or operator) of the above-described well, being first duly sworn on oath, says: That I have knowledge of the facts, statements, and matters herein contained and the log of the above-described well as filed and that the same are true and correct. So help me God.

(Signature) James Tasheff

1620 Wichita Plaza, Wichita, Kansas

(Address)

SUBSCRIBED AND SWORN TO before me this 20th day of December, 19 66

My commission expires December 6, 1970

Norma Richey

Notary Public.

DRILLER'S LOG

J. Marshall Nye
 BEFORT #1
 NE SW SW Sec. 19-14S-18W
 Ellis County, Kansas

Commenced: December 11, 1966

Completed: December 19, 1966

Braden Drilling, Inc., Contractor

Set 8 5/8" casing at 242' with landing joint
 and cemented with 175 sacks cement
 2% gel and 2% c.c.

<u>Formation</u>	<u>From</u>	<u>To</u>
Surface Clay, Sand and Shale	0	135
Sand and Shale	135	243
Shale, Red Bed and Sand	243	1110
Red Bed and Sand	1110	1335
Anhydrite	1335	1378
Shale	1378	1865
Shale and Shells	1865	2240
Shale and Lime	2240	3435
Lime	3435	3775 T.D.

I hereby certify that this is a true and correct log of the above
 captioned well as shown by the daily drilling reports.

James Tasheff
 James Tasheff

Subscribed and sworn to before me this 20th day of December, 1966.

My commission expires December 6, 1970

Norma Richey
 Norma Richey - Notary Public