


Give All Information Completely  
Make Required Affidavit  
Mail or Deliver Report to:  
Conservation Division  
State Corporation Commission  
800 Bitting Building  
Wichita, Kansas

OR

FORMATION PLUGGING RECORD

Strike out upper line  
when reporting plug-  
ging off formations.

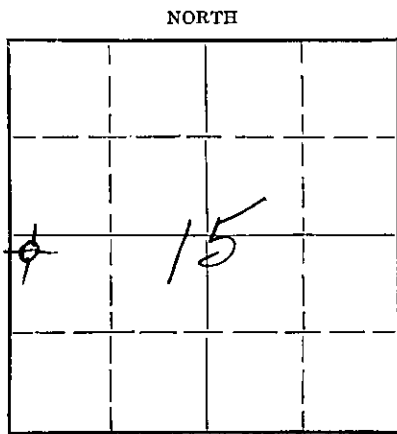

Locate well correctly on above  
Section Plat

Ellis County. Sec. 15 Twp. 14S Rge. (E) 18 (W)  
Location as "NE $\frac{1}{4}$ NW $\frac{1}{4}$ SW $\frac{1}{4}$ " or footage from lines NW NW SW  
Lease Owner Deep Rock Oil Corp. and Rine Drilling Co.  
Lease Name Binder Well No. 1  
Office Address 320 Central Building Wichita, Kansas  
Character of Well (completed as Oil, Gas or Dry Hole) Dry Hole  
Date well completed April 8, 1949 19  
Application for plugging filed April 8, 1949 - Telephone 19  
Application for plugging approved April 8, 1949 - Telephone 19  
Plugging commenced April 8, 1949 19  
Plugging completed April 8, 1949 19  
Reason for abandonment of well or producing formation Dry Hole  
If a producing well is abandoned, date of last production None 19  
Was permission obtained from the Conservation Division or its agents before plugging was com-  
menced? Yes - Telephone - Confirmed 4/11/49  
Name of Conservation Agent who supervised plugging of this well C. D. Stough - Great Bend, Kansas  
Producing formation None Depth to top - Bottom - Total Depth of Well 3670 Feet  
Show depth and thickness of all water, oil and gas formations.

OIL, GAS OR WATER RECORDS

CASING RECORD

Formation	Content	From	To	Size	Put In	Pulled Out
Surface	Sand & Shale	0	1208	8-5/8	3/30/49	None

Describe in detail the manner in which the well was plugged, indicating where the mud fluid was placed and the method or methods used in introducing it into the hole. If cement or other plugs were used, state the character of same and depth placed, from \_\_\_\_\_ feet to \_\_\_\_\_ feet for each plug set.

Heavy mud from 3670 to 200' - Bridged @ 200' w/ 15 sacks cement.  
Heavy mud from bridge @ 200' to 10' - filled from 10' to surface  
with 10 sacks cement.

(If additional description is necessary, use BACK of this sheet)

Correspondence regarding this well should be addressed to R. W. Rine Drilling Co. 04-16-49  
Address 320 Central Building Wichita, Kansas

STATE OF Kansas, COUNTY OF Sedgwick, ss.  
E. H. Sloyer (employee of owner) or (owner or operator) of the above-described well,  
being first duly sworn on oath, says: That I have knowledge of the facts, statements, and matters herein contained and the log of the above-  
described well as filed and that the same are true and correct. So help me God.

(Signature) R. W. Rine Drilling Company

By E. H. Sloyer (Address)

SUBSCRIBED AND SWORN to before me this 15 day of April, 1949

R. M. Green

Notary Public.

My commission expires December 29, 1952

PLUGGING  
FILE SEC 15 T 14 R 18 W  
BOOK PAGE 90 LINE 34

Binder No. 1 Well

NW NW SW  
15-14-18  
Ellis County, Kansas

Contractor: R. W. Rine Drilling Company  
Started: 3/28/49 Finished: 4/8/49

Log

Clay, shale, etc.	0- 280	
Shale, sand	280- 654	
Sand	654- 890	
Shale	890- 965	
Shale, Red bed	965-1200	
Shale	1200-1204	
Anhydrite	1204-1208	8-5/8" w/ 450 @ 1208
Cement	1170-1208	
Anhydrite	1208-1230	
Shells, shale, lime	1925-2095	
Lime, shale	2095-3070	
Lime	3070-3235	
Lime, shale	3235-3305	
Lime	3305-3555	
Lime, shale	3555-3620	
Lime	3620-3670	TD

D & A

State of Kansas )  
County of Sedgwick) <sup>ss</sup>

I, E. H. Sloyer, do hereby certify that the above is a true and accurate log of the Binder Well No. 1 located in the NW/4 of the NW/4 of the SW/4 of Section 15-14-18, Ellis County, Kansas.

E. H. Sloyer  
Assistant Secretary

Sworn to and subscribed before me this 14th day of April, 1949.

R. M. Green  
Notary Public

My commission expires December 29, 1952.

**PLUGGING**  
FILE SEC 15 T 14 R 18 W  
BOOK PAGE 90 LINE 34