


WELL PLUGGING RECORD

Give All Information Completely
Make Required Affidavit
Mail or Deliver Report to:
Conservation Division
State Corporation Commission
211 No. Broadway
Wichita, Kansas

ELLIS County, Sec. 15 Twp. 14 Rge. 18 (X) W (W)

Location as "NE/CNW/SW" or footage from lines Approx. SE SE NE
Lease Owner PETROLEUM, INC.
Lease Name BOARD OF REGENTS "B" Well No. 1
Office Address ROUTE 2, GREAT BEND, KANSAS
Character of Well (completed as Oil, Gas or Dry Hole) DRY HOLE
Date well completed November 23, 19 57
Application for plugging filed November 25, 19 57
Application for plugging approved November 23, 19 57
Plugging commenced November 23, 19 57
Plugging completed November 23, 19 57

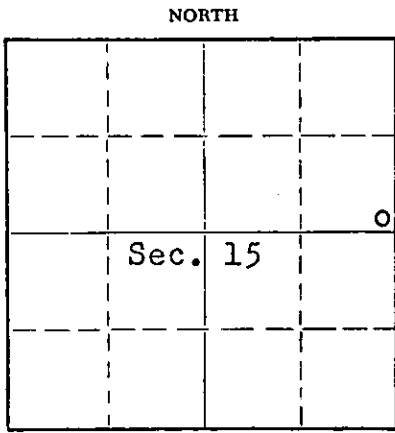

Locate well correctly on above Section Plat

Reason for abandonment of well or producing formation
No Producible Zones

If a producing well is abandoned, date of last production None 19

Was permission obtained from the Conservation Division or its agents before plugging was commenced? Yes

Name of Conservation Agent who supervised plugging of this well Eldon Petty, Box 326, Hays, Kansas
Producing formation ----- Depth to top --- Bottom --- Total Depth of Well 3660' Feet

Show depth and thickness of all water, oil and gas formations.

OIL, GAS OR WATER RECORDS

CASING RECORD

FORMATION	CONTENT	FROM	TO	SIZE	PUT IN	PULLED OUT
				8-5/8"	1215'	None

Describe in detail the manner in which the well was plugged, indicating where the mud fluid was placed and the method or methods used in introducing it into the hole. If cement or other plugs were used, state the character of same and depth placed, from feet to feet for each plug set.

Mud up with heavy mud to 600' followed by wooden plug. Placed 40 sacks cement through drill pipe on to plug. Mud up to 240' followed by wooden plug. Placed 40 sacks cement through drill pipe on to plug. Mud up to 40' followed by wooden plug and 10 sacks cement to base of well cellar.

DEC 12-04-57

(If additional description is necessary, use BACK of this sheet)

Name of Plugging Contractor GARVEY DRILLING COMPANY
Address ROUTE 2, GREAT BEND, KANSAS

STATE OF KANSAS, COUNTY OF BARTON, ss.
Don Searle (employee of owner) or ~~(known to operator)~~ of the above-described well, being first duly sworn on oath, says: That I have knowledge of the facts, statements, and matters herein contained and the log of the above-described well as filed and that the same are true and correct. So help me God.

(Signature) Don Searle
Route 2, Great Bend, Kansas
(Address)

SUBSCRIBED AND SWORN TO before me this 2nd day of December, 19 57

My commission expires July 11, 1960 Ed J. Brown Notary Public.

PLUGGING
FILE SEC. 15 T. 14 R. 18W
BOOK PAGE 64 LINE 2

WELL LOG 15-051-00591-00-00

COMPANY PETROLEUM, INCORPORATED

SEC. 15 T. 14S R. 18W

FARM BOARD OF REGENTS "B" NO. 1


LOC. SE,SE,NE (Approx)

TOTAL DEPTH 3660'

COUNTY ELLIS CO., KANSAS

COMM. November 13, 1957 COMP. November 23, 1957

CONTRACTOR GARVEY DRILLING COMPANY

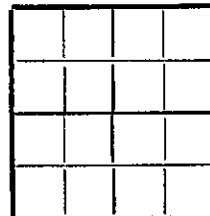

CABING 8 5/8" @ 1215' W/450 sax.

ELEVATION 1998' DF

PRODUCTION D & A

FIGURES INDICATE BOTTOM OF FORMATIONS

40	Surface rock
140	Surface clay & shale
625	Shale
850	Sand & shale
1205	Shale & shells
1245	Anhydrite
1930	Shale & shells
2265	Lime & shale
2365	Lime
3145	Lime & shale
3561	Lime
3630	Conglomerate
3660'	Arbuckle
3660	T. D.

DEC 4 1957

PLUGGING
FILE: SEC. 15 T. 14 R. 18W
BOOK PAGE 64 LINE 2

State of KANSAS
County of BARTON

I, VERNE A. MORRIS of GARVEY DRILLING COMPANY

upon oath state that the above and foregoing is a true and correct copy of the log of the #1 "B" Board of Regents

Verne A. Morris

Subscribed and sworn to before me this 2nd day of December 1957

My Commission Expires: July 11, 1960

Ed J. Brown
NOTARY PUBLIC