


STATE OF KANSAS
STATE CORPORATION COMMISSION

Give All Information Completely
Make Required Affidavit
Mail or Deliver Report to:
Conservation Division
State Corporation Commission
211 No. Broadway
Wichita, Kansas

WELL PLUGGING RECORD

15-051-19474-00-00

NORTH

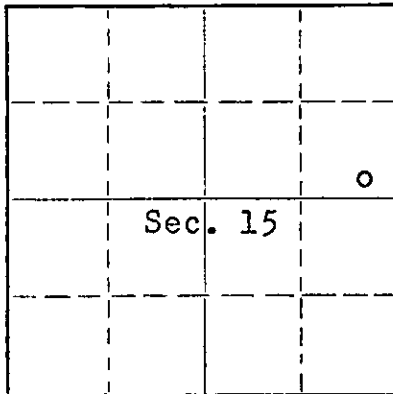

Locate well correctly on above
Section Plat

ELLIS

County. Sec. 15 Twp. 14 Rge. 18 (X) W (W)

Location as "NE/CNW/SW" or footage from lines. SE SE NE

Lease Owner PETROLEUM, INC.

Lease Name BOARD OF REGENTS "B" Well No. 1

Office Address ROUTE 2, GREAT BEND, KANSAS

Character of Well (completed as Oil, Gas or Dry Hole) DRY HOLE

Date well completed November 13, 19 57

Application for plugging filed November 15, 19 57

Application for plugging approved November 13, 19 57

Plugging commenced November 13, 19 57

Plugging completed November 13, 19 57

Reason for abandonment of well or producing formation Stuck surface pipe and

was unable to recover same, abandoned hole, skidded

rig 10' and started new surface hole.

If a producing well is abandoned, date of last production None 19

Was permission obtained from the Conservation Division or its agents before plugging was commenced? Yes

Name of Conservation Agent who supervised plugging of this well Eldon Petty, Box 326, Hays, Kansas

Producing formation ----- Depth to top --- Bottom --- Total Depth of Well 1214 Feet

Show depth and thickness of all water, oil and gas formations.

OIL, GAS OR WATER RECORDS

CASING RECORD

FORMATION	CONTENT	FROM	TO	SIZE	PUT IN	PULLED OUT
				8-5/8"	1092'	888'

Describe in detail the manner in which the well was plugged, indicating where the mud fluid was placed and the method or methods used in introducing it into the hole. If cement or other plugs were used, state the character of same and depth placed, from _____ feet to _____ feet for each plug set.

Mud up with heavy mud to 620' followed by wooden plug. Placed 75 sacks cement through drill pipe on to plug. Mud up to 240' followed by wooden plug and 225 sacks cement to base of well cellar.

11-30-57
NOV 30

(If additional description is necessary, use BACK of this sheet)
Name of Plugging Contractor GARVEY DRILLING COMPANY
Address ROUTE 2, GREAT BEND, KANSAS

STATE OF KANSAS, COUNTY OF BARTON, ss.
Don Searle (employee of owner) or (NOTARY PUBLIC) of the above-described

well, being first duly sworn on oath, says: That I have knowledge of the facts, statements, and matters herein contained and the log of the above-described well as filed and that the same are true and correct. So help me God.

(Signature) Don Searle

Route 2, Great Bend, Kansas
(Address)

SUBSCRIBED AND SWORN to before me this 29th day of November, 19 57

My commission expires July 11, 1960 Notary Public.

PLUGGING
FILED 15 T 14 R 18 W
BOOK PAGE 62 LINE 8

WELL LOG

15-051-19474-00-00

COMPANY PETROLEUM, INCORPORATED

SEC. 15 T. 14S R. 18W

FARM BOARD OF REGENTS "B" NO. 1

LOC. SE, SE, NE


TOTAL DEPTH 1214'

COUNTY ELLIS CO., KANSAS

COMM. November 9, 1957

COMP. November 13, 1957

CONTRACTOR GARVEY DRILLING COMPANY

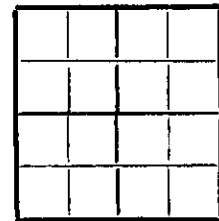

CASING Lost 204' of 8 5/8" in hole.

ELEVATION 1998' DF

PRODUCTION Plugged & Abandoned

FIGURES INDICATE BOTTOM OF FORMATIONS

80	Surface clay & sand
370	Shale
435	Red bed
650	Shale & shells
835	Sand & pyrite
850	Shells
900	Shale & shells
1065	Red bed & shells
1206	Shale & shells
1214	Anhydrite
1214	T. D.

Lost 204' of 8 5/8" casing in hole; skid rig.

RECEIVED
NOV 30 1957
DIVISION
Wichita, Kansas

PLUGGING
FILE SEC 15 T 14 R 18W
BOOK PAGE 62 LINE 8

State of KANSAS

County of BARTON

ss:

I, VERNE A. MORRIS of GARVEY DRILLING COMPANY

upon oath state that the above and foregoing is a true and correct copy of the log of the #1 Board of Regents "B"

Subscribed and sworn to before me this 29th day of November 19 57

My Commission Expires: July 11, 1960

Verne A. Morris
Notary Public
NOTARY PUBLIC