


Give All Information Completely  
Make Required Affidavit  
Mail or Deliver Report to:  
Conservation Division  
State Corporation Commission  
211 No. Broadway  
Wichita, Kansas

NORTH

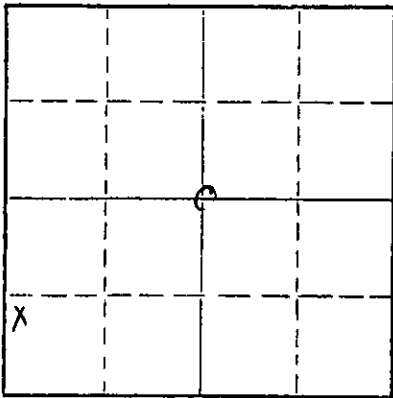

Locate well correctly on above  
Section Plat

Ellis County, Sec. 6 Twp. 14S Rge. (E/18) (W)  
Location as "NE/CNW&SW" or footage from lines NW SW SW  
Lease Owner Abercrombie Drilling, Inc.  
Lease Name Fort Hays State College Well No. 1  
Office Address 801 Union Center, Wichita, Kansas  
Character of Well (completed as Oil, Gas or Dry Hole) Dry Hole  
Date well completed June 15, 19 66  
Application for plugging filed verbally June 15, 19 66  
Application for plugging approved verbally June 15, 19 66  
Plugging commenced June 15, 19 66  
Plugging completed June 15, 19 66

Reason for abandonment of well or producing formation Dry  
If a producing well is abandoned, date of last production 19  
Was permission obtained from the Conservation Division or its agents before plugging was commenced? Yes - Verbally

Name of Conservation Agent who supervised plugging of this well L. F. Massey  
Producing formation \_\_\_\_\_ Depth to top \_\_\_\_\_ Bottom \_\_\_\_\_ Total Depth of Well 3766 Feet  
Show depth and thickness of all water, oil and gas formations.

OIL, GAS OR WATER RECORDS

CASING RECORD

FORMATION	CONTENT	FROM	TO	SIZE	PUT IN	PULLED OUT
				7"	266'	None

Describe in detail the manner in which the well was plugged, indicating where the mud fluid was placed and the method or methods used in introducing it into the hole. If cement or other plugs were used, state the character of same and depth placed, from \_\_\_\_\_ feet to \_\_\_\_\_ feet for each plug set.

Set 1st plug @ 540' w/25 sx cement  
Set 2nd plug @ 250' w/20 sx cement  
Set 3rd plug @ 40' w/10 sx cement

JUN 20 1966 *De-22-66*

(If additional description is necessary, use BACK of this sheet)  
Name of Plugging Contractor Abercrombie Drilling, Inc.  
Address 801 Union Center, Wichita, Kansas

STATE OF Kansas, COUNTY OF Sedgwick, ss.  
Jack K. Wharton (employee of owner) or (owner/operator) of the above-described well, being first duly sworn on oath, says: That I have knowledge of the facts, statements, and matters herein contained and the log of the above-described well as filed and that the same are true and correct. So help me God.

(Signature) Jack K. Wharton  
801 Union Center, Wichita, Kansas  
(Address)

SUBSCRIBED AND SWORN TO before me this 21st day of June, 19 66

My commission expires March 31, 1970  
Margie Dee Montgomery Notary Public.

