


STATE OF KANSAS
STATE CORPORATION COMMISSION

WELL PLUGGING RECORD

Give All Information Completely
State Required Affidavit
of Driller Report to
Conservation Division
State Corporation Comm.
245 North Water
Wichita, KS 67202

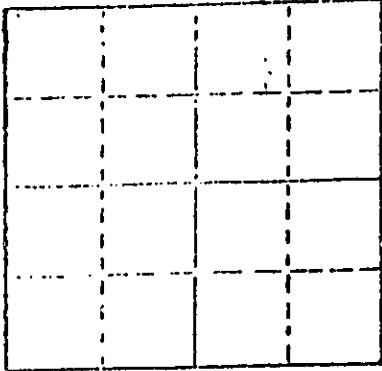

Ellis County, Sec. 1 Twp. 14 Rge. 18 X/W
Location as "RE/CNW\SW\1" or Footage from Lines
~~SW-NE-NE~~ SENE
Lease Owner Dreiling Resources, Inc.
Lease Name Lang D Well No. 2
Office Address P. O. Box 278, Victoria, KS 67671
Character of Well (Completed as Oil, Gas or Dry Hole)
Dry Hole

Date Well completed 11-23 1982
Application for plugging filed 11-23 1982
Application for plugging approved 11-23 1982
Plugging commenced 11-23 1982
Plugging completed 11-23 1982
Reason for abandonment of well or producing formation

If a producing well is abandoned, date of last production 19

Was permission obtained from the Conservation Division or its agents before plugging was commenced? Yes

Name of Conservation Agent who supervised plugging of this well Dale Baltazor
Producing formation Depth to top Bottom Total Depth of Well 3620'
Show depth and thickness of all water, oil and gas formations.

OIL, GAS OR WATER RECORDS

CASING RECORD

FORMATION	CONTENT	FROM	TO	SIZE	PUT IN	PULLED OUT
				8 5/8"	163'	-0-

Describe in detail the manner in which the well was plugged, indicating where the mud fluid was placed and the method or methods used in introducing it into the hole. If cement or other plugs were used, state the character of same and depth placed, from _____ foot to _____ feet for each plug set.

- 1st plug was set at 1325' with 25 sacks cement
- 2nd plug was set at 660' with 80 sacks cement
- 3rd plug was set at 200' with 40 sacks cement
- 4th plug was set at 40' with 10 sacks cement

(If additional description is necessary, use BACK of this sheet)

Name of Plugging Contractor Dreiling Oil, Inc., R.R. #1, Victoria, KS 67671

STATE OF _____ COUNTY OF _____, ss.
(employee of owner) or (owner or operator)
of the above-described well, being first duly sworn on oath, says: That I have knowledge of the facts, statements, and matters herein contained and the log of the above-described well as filed and that the same are true and correct. help me God.

(Signature) _____
(Address) P.O. Box 278 - Victoria, KS

SUBSCRIBED AND SWORN TO before me this 7th day of December, 1982

PAUL GROSS
STATE NOTARY PUBLIC
Ellis County, Kansas
My Appt. Expires April 7, 1984

Notary Public.

My commission expires

RECEIVED
STATE CORPORATION COMMISSION

FEB 10 1983

CONSERVATION DIVISION
Wichita, Kansas