

CARD MUST BE TYPED

State of Kansas

CARD MUST BE SIGNED

NOTICE OF INTENTION TO DRILL CORRECTION ON FOOTAGE

(see rules on reverse side)

(Irregular Section) 6-1-87

Starting Date 6 month 12 day 87 year

API Number 15-051-24,486-00-00

OPERATOR: License # 8035
Name Franklin Kenec
Address 3130 Templeton Gap Road
City/State/Zip Colorado Springs, Co. 80907
Contact Person Franklin Kenec
Phone 303-632-8271

SW SW SW Sec. 7 Twp. 14 S, Rg. 18
330 Ft. from South Line of Section
4785 Ft. from East Line of Section

(Note: Locate well on Section Plat on reverse side)

CONTRACTOR: License # 5671
Name Revlin Drlg., Inc.
City/State Box 293 Russell, Kansas 67665

Nearest lease or unit boundary line 330 feet
County Ellis
Lease Name Sentinel Hill Well # 3

Well Drilled For: Well Class: Type Equipment:
X Oil SWD X Infield X Mud Rotary
Gas Inj Pool Ext Air Rotary
OWWO Expl Wildcat Cable

Ground surface elevation 2169.6 ft. MSL
Domestic well within 330 feet: yes X no
Municipal well within one mile: yes X no
Depth to bottom of fresh water 60
Depth to bottom of usable water 680
Surface pipe by Alternate: 1 X 2
Surface pipe planned to be set 700 x 8 5/8
Conductor pipe required n/a
Projected Total Depth 3815 feet
Formation Arbuckle

If OWWO: old well info as follows:
Operator
Well Name
Comp Date Old Total Depth

I certify that well will comply with K.S.A. 55-101, et seq., plus eventually plugging hole to KCC specifications.
Date May 28, 1987 Signature of Operator or Agent Paula J. Silcox Title Agent

For KCC Use:
Conductor Pipe Required feet; Minimum Surface Pipe Required 700 feet per Alt.
This Authorization Expires 11-27-87 Approved By S. 27-87


twas. 4950 FEL

Must be filed with the K.C.C. five (5) days prior to commencing well
This card void if drilling not started within six (6) months of date received by K.C.C.

Important procedures to follow:

1. Notify District office before setting surface casing.
2. Set surface casing by circulating cement to the top.
3. File completion forms ACO-1 with K.C.C. within 90 days of well completion, following instructions on ACO-1, side 1, and including copies of wireline logs.
4. Notify District office 48 hours prior to old well workover or re-entry.
5. Prior to filing Intent, prepare a proposed plugging plan in case well is D & A, then obtain approval of plan when calling district office prior to setting surface pipe.
6. Submit plugging report (CP-4) to K.C.C. after plugging is completed.
7. Obtain an approved injection docket number before disposing of salt water.
8. Notify K.C.C. within 10 days when injection commences or terminates.
9. If an alternate 2 completion, cement in the production pipe from below any usable water to surface within 120 days of spud date.

**A Regular Section of Land
1 Mile = 5,280 Ft.**

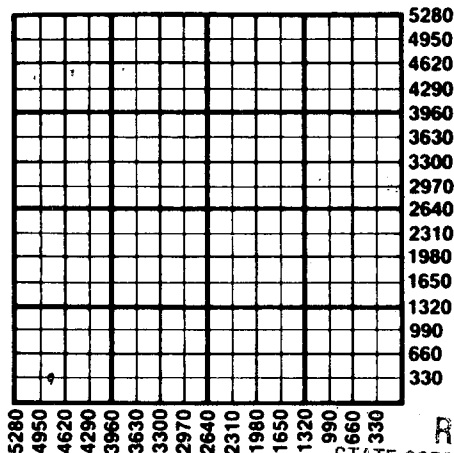

RECEIVED
STATE CORPORATION COMMISSION

JUN - 1 1987
06-01-87
CONSERVATION DIVISION
Wichita, Kansas

State Corporation Commission of Kansas
Conservation Division
200 Colorado Derby Building
Wichita, Kansas 67202
(316) 263-3238