

CARD MUST BE TYPED

State of Kansas
NOTICE OF INTENTION TO DRILL
 (see rules on reverse side)

CARD MUST BE SIGNED

Starting Date: 12 3 84
 month day year 402

OPERATOR: License # 5171
 Name TXO Production Corp.
 Address 200 W. Douglas, Suite 300
 City/State/Zip Wichita, KS 67202
 Contact Person Gary Wurdeman
 Phone 316-265-9441

CONTRACTOR: License # 5422
 Name Abercrombie Drilling, Inc.
 City/State Wichita, KS 67202

Well Drilled For:	Well Class:	Type Equipment:
☒ Oil	☐ Swd	☒ Mud Rotary
☐ Gas	☐ Inj	☐ Air Rotary
☒ OWWO	☐ Expl	☐ Cable

If OWWO: old well info as follows:

Operator Sunray Oil Corporation
 Well Name KANSAS STATE "A" #1
 Comp Date 10-6-52 Old Total Depth 3726'
 Projected Total Depth 3726' feet
 Projected Formation at TD Arbuckle
 Expected Producing Formations Arbuckle

I certify that we will comply with K.S.A. 55-101, et seq., plus eventually plugging hole to K.C.C. specifications.

Date 12-3-84 Signature of Operator or Agent

API Number 15- 051-01026-00-01

SE SE SE Sec 7 Twp 14 S, Rge 18
 (location) ☐ East ☒ West

330 Ft North from Southeast Corner of Section
 330 Ft West from Southeast Corner of Section
 (Note: Locate well on Section Plat on reverse side)

Nearest lease or unit boundary line 330 feet.

County Ellis

Lease Name STATE OF KANSAS Well# 1

Domestic well within 330 feet: ☐ yes ☒ noMunicipal well within one mile: ☐ yes ☒ no

Depth to Bottom of fresh water 100 feet

Lowest usable water formation Unknown

Depth to Bottom of usable water 600 feet

Surface pipe by Alternate: 1 ☐ 2 ☒

Surface pipe to be set 268 already set feet

Conductor pipe if any required 0 feet

Ground surface elevation TBD feet MSL

This Authorization Expires 6-3-85

Approved By 12-3-84

Title District Engineer


Form C-1 4/84

MHC/40HE 12/3/84

Must be filed with the K.C.C. five (5) days prior to commencing well
This card void if drilling not started within six (6) months of date received by K.C.C.

Important procedures to follow :

**A Regular Section of Land
1 Mile = 5,280 Ft.**

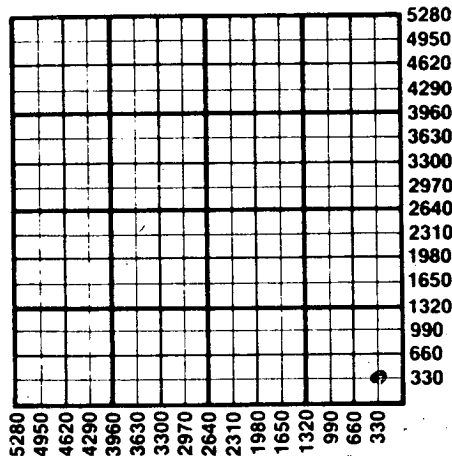

1. Notify District office before setting surface casing.
 2. Set surface casing by circulating cement to the top.
 3. File completion forms ACO-1 with K.C.C. within 90 days of well completion, following instructions on ACO-1, side 1, and including copies of wireline logs.
 4. Notify District office 48 hours prior to old well workover or re-entry.
 5. Prior to plugging, prepare a plugging plan, then obtain agreement from the appropriate district office for an approved plugging plan.
 6. Submit plugging report (CP-4) to K.C.C. after plugging is completed.
 7. Obtain an approved injection docket number before disposing of salt water.
- Notify K.C.C. within 10 days when injection commences or terminates.
- Alternate 2 completion, cement in the production pipe from below any usable water to surface within 120 days of spud date.

RECEIVED
STATE CORPORATION COMMISSION

DEC 3 1984
12-03-84
CONSERVATION DIVISION
Wichita, Kansas

State Corporation Commission of Kansas
Conservation Division
200 Colorado Derby Building
Wichita, Kansas 67202
(316) 263-3238