

15-071-20722-00-00

FOR KCC USE:

FORM C-1 7/91  
FORM MUST BE TYPED  
FORM MUST BE SIGNED  
ALL BLANKS MUST BE FILLED

EFFECTIVE DATE: 1-4-2000  
DISTRICT # 1  
SGA?  Yes  No

State of Kansas  
NOTICE OF INTENTION TO DRILL

Must be approved by the K.C.C. five (5) days prior to commencing well.

Expected Spud Date ... 1 ... 15 ... 2000 ...  
month day year

Spot APPROX.  
NE SE NW Sec .26 Twp .18S Rg .40W  East  
 West

OPERATOR: License # 32511  
Name: Imperial American Oil Corporation  
Address: 10004 W 20th St N  
City/State/Zip: Wichita KS 67212  
Contact Person: Hal C. Porter  
Phone: 316-773-3808

1755 feet from South (North) line of Section  
1620 feet from East (West) line of Section  
IS SECTION  REGULAR  IRREGULAR?

CONTRACTOR: License #: 30606  
Name: Murfin Drilling Company, Inc.

(NOTE: Locate well on the Section Plat on Reverse Side)  
County: Greeley  
Lease Name: Waldren Estate Well #: 1  
Field Name: Bradshaw

Well Drilled For: Well Class: Type Equipment:  
Oil Enh Rec  Infield  Mud Rotary  
 Gas Storage Pool Ext. Air Rotary  
OWWO Disposal Wildcat Cable  
Seismic: # of Holes Other

Is this a Prorated/Spaced Field?  yes  no  
Target Formation(s): Towanda  
Nearest lease or unit boundary: 330'  
Ground Surface Elevation: 3549 feet MSL  
Water well within one-quarter mile:  yes  no  
Public water supply well within one mile:  yes  no  
Depth to bottom of fresh water: 150-180  
Depth to bottom of usable water: 1480 PERMIAN  
Surface Pipe by Alternate: 1  2  
Length of Surface Pipe Planned to be set: 250'  
Length of Conductor pipe required: None  
Projected Total Depth: 3000'  
Formation at Total Depth: Towanda  
Water Source for Drilling Operations:  
 well  farm pond  other

If OWWO: old well information as follows:  
Operator:  
Well Name:  
Comp. Date: Old Total Depth:  
Directional, Deviated or Horizontal wellbore?  yes  no  
If yes, true vertical depth:  
Bottom Hole Location:

Will Cores Be Taken?  yes  no  
If yes, proposed zone:

AFFIDAVIT

The undersigned hereby affirms that the drilling, completion and eventual plugging of this well will comply with K.S.A. 55-101 et. seq.

- It is agreed that the following minimum requirements will be met:
1. Notify the appropriate district office prior to spudding of well;
  2. A copy of the approved notice of intent to drill shall be posted on each drilling rig;
  3. The minimum amount of surface pipe as specified below shall be set by circulating cement to the top; in all cases surface pipe shall be set through all unconsolidated materials plus a minimum of 20 feet into the underlying formation;
  4. If the well is dry hole, an agreement between the operator and the district office on plug length and placement is necessary prior to plugging;
  5. The appropriate district office will be notified before well is either plugged or production casing is cemented in;
  6. IF AN ALTERNATE II COMPLETION, PRODUCTION PIPE SHALL BE CEMENTED FROM BELOW ANY USABLE WATER TO SURFACE WITHIN 120 DAYS OF SPUD DATE. IN ALL CASES, NOTIFY DISTRICT OFFICE PRIOR TO ANY CEMENTING.

I hereby certify that the statements made herein are true and to the best of my knowledge and belief.

Date: September 30, 1999 Signature of Operator or Agent: Hal C. Porter Title: President

FOR KCC USE:  
API # 15- 071-20722-0000  
Conductor pipe required NONE feet  
Minimum surface pipe required 200 feet per Alt.  2  
Approved by: JK 12-30-99  
This authorization expires: 6-30-2000  
(This authorization void if drilling not started within 6 months of effective date.)  
Spud date: \_\_\_\_\_ Agent: \_\_\_\_\_

RECEIVED  
ST. CORPORATION COMMISSION

DEC 29 1999  
12-29-99  
Conservation Division  
Wichita, Kansas

REMEMBER TO:

- File Drill Pit Application (form CDP-1) with Intent to Drill;
- File Completion Form ACO-1 within 120 days of spud date;
- File acreage attribution plat according to field proration orders;
- Notify appropriate district office 48 hours prior to workover or re-entry;
- Submit plugging report (CP-4) after plugging is completed;
- Obtain written approval before disposing or injecting salt water.

Mail to: KCC - Conservation Division, 130 S. Market - Room 2078, Wichita, Kansas 67202.

26  
18  
40W

20-20-40700-170-21

**IN ALL CASES PLOT THE INTENDED WELL ON THE PLAT BELOW**

**PLAT OF ACREAGE ATTRIBUTABLE TO A WELL IN A PRORATED OR SPACED FIELD**

If the intended well is in a prorated or spaced field, please fully complete this side of the form. If the intended well is in a prorated or spaced field complete the plat below showing that the well will be properly located in relationship to other wells producing from the common source of supply. Please show all the wells within 1 mile of the boundaries of the proposed acreage attribution unit for gas wells and within 1/2 mile of the boundaries of the proposed acreage attribution unit for oil wells.

API NO. 15- \_\_\_\_\_  
O P E R A T O R \_\_\_\_\_



LOCATION OF WELL: COUNTY \_\_\_\_\_

LEASE \_\_\_\_\_ feet from south/north line of section  
WELL NUMBER \_\_\_\_\_ feet from east/west line of section  
FIELD \_\_\_\_\_ SECTION \_\_\_\_\_ TWP \_\_\_\_\_ RG \_\_\_\_\_

NUMBER OF ACRES ATTRIBUTABLE TO WELL \_\_\_\_\_ IS SECTION \_\_\_\_\_ REGULAR or \_\_\_\_\_ IRREGULAR  
QTR/QTR/QTR OF ACREAGE \_\_\_\_\_ - \_\_\_\_\_ - \_\_\_\_\_ **IF SECTION IS IRREGULAR, LOCATE WELL FROM NEAREST CORNER BOUNDARY.**

Section corner used: \_\_\_\_\_ NE \_\_\_\_\_ NW \_\_\_\_\_ SE \_\_\_\_\_ SW  
**PLAT**

(Show location of the well and shade attributable acreage for prorated or spaced wells.)  
(Show footage to the nearest lease or unit boundary line.)

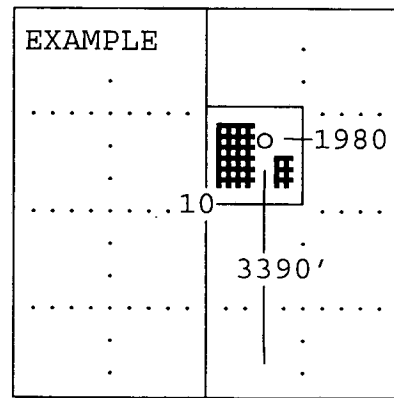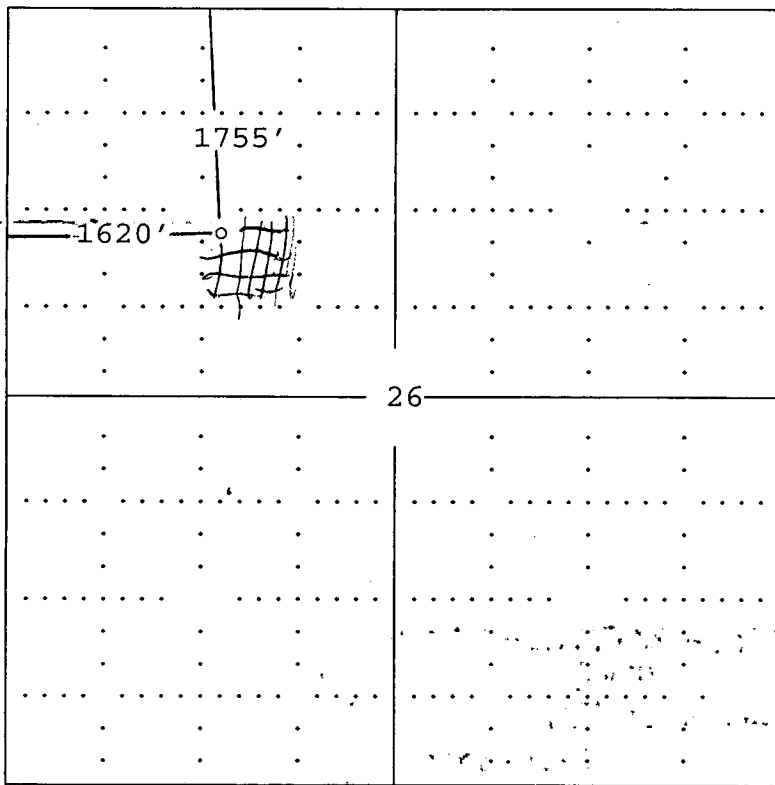

SEWARD CO.

**In plotting the proposed location of the well, you must show:**

- 1) The manner in which you are using the depicted plat by identifying section lines, i.e. 1 section, 1 section with 8 surrounding sections, 4 sections, etc.;
- 2) the distance of the proposed drilling location from the section's south/north and east/west; and
- 3) the distance to the nearest lease or unit boundary line.

RECEIVED  
ST. CONSERVATION COMMISSION

DEC 29 1977

Conservation Division  
Wichita, Kansas