

NOTICE OF INTENTION TO DRILL

(see rules on reverse side)

Starting Date 12 22 86 month day year

API Number 15- 071-20,433-0000

OPERATOR: License # 5476 Name DNB Drilling, Inc. Address 535 N. Oliver City/State/Zip Wichita, KS 67208 Contact Person James Donelson Phone (316) 687-5471

NW NW Sec 33 Twp 18 S, Rg 41 X West 4620' Ft. from South Line of Section 4620' Ft. from East Line of Section

(Note: Locate well on Section Plat on reverse side)

CONTRACTOR: License # 5382 Name Cheyenne Drlg. Inc. City/State Garden City, KS 67846

Nearest lease or unit boundary line 660' feet County Greeley Lease Name Larson Well # 1

Well Drilled For: X Oil SWD Infield X Mud Rotary X Gas Inj Pool Ext Air Rotary OWWO Expl Wildcat Cable

Ground surface elevation 3708' feet MSL Domestic well within 330 feet: yes Xno

If OWWO: old well info as follows: Operator Well Name Comp Date Old Total Depth

Municipal well within one mile: yes Xno

Depth to bottom of fresh water 120'

Depth to bottom of usable water 1200 1575

Surface pipe by Alternate: 1 2 X

Surface pipe planned to be set 320'

Conductor pipe required

Projected Total Depth 5700' feet

Formation Mississippian Osage

I certify that well will comply with K.S.A. 55-101, et seq., plus eventually plugging hole to KCC specifications.

Date 12-18-86 Signature of Operator or Agent Title Office Manager

For KCC Use:

Conductor Pipe Required feet; Minimum Surface Pipe Required 250 feet per Alt. 4 2

This Authorization Expires 6-18-87 Approved By 12-18-86


Handwritten signature and initials: RCH/KCC

Must be filed with the K.C.C. five (5) days prior to commencing well  
 This card void if drilling not started within six (6) months of date received by K.C.C.

**Important procedures to follow:**

1. Notify District office before setting surface casing.
2. Set surface casing by circulating cement to the top.
3. File completion forms ACO-1 with K.C.C. within 90 days of well completion, following instructions on ACO-1, side 1, and including copies of wireline logs.
4. Notify District office 48 hours prior to old well workover or re-entry.
5. Prior to filing Intent, prepare a proposed plugging plan in case well is D & A, then obtain approval of plan when calling district office prior to setting surface pipe.
6. Submit plugging report (CP-4) to K.C.C. after plugging is completed.
7. Obtain an approved injection docket number before disposing of salt water.
8. Notify K.C.C. within 10 days when injection commences or terminates.

**A Regular Section of Land**  
 1 Mile = 5,280 Ft.

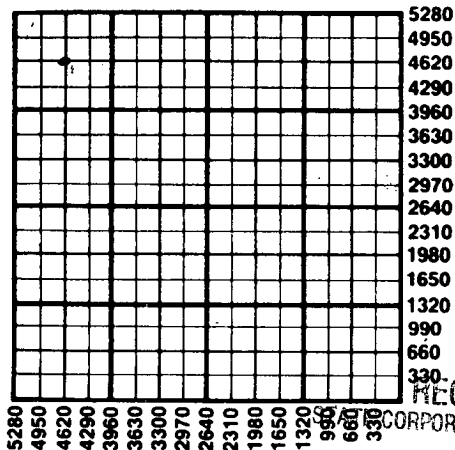

RECEIVED

DEC 18 1986  
 12-18-86  
 CONSERVATION DIVISION  
 Wichita, Kansas

of an alternate 2 completion, cement in the production pipe from below any usable water to surface within 120 days of spud date.

State Corporation Commission of Kansas  
 Conservation Division  
 200 Colorado Derby Building  
 Wichita, Kansas 67202  
 (316) 263-3238