

EFFECTIVE DATE: 9-26-90

15-071-20524-00-00

FORM MUST BE TYPED

State of Kansas

FORM MUST BE SIGNED

FORM C-1 4/90

NOTICE OF INTENTION TO DRILL

ALL BLANKS MUST BE FILLED

Must be approved by the K.C.C. five (5) days prior to commencing well

Expected Spud Date September 19, 1990
month day year

APP NE NW SW Sec 14 Twp 18 S, Rg 43 East West

OPERATOR: License # 5952
Name: Amoco Production Company
Address: P.O. Box 800, Rm. 1833
City/State/Zip: Denver, CO 80201
Contact Person: J.A. Victor
Phone: 303/830-4009

2130 feet from South line of Section
3255 feet from East line of Section
(Note: Locate well on Section Plat on Reverse Side)

CONTRACTOR: License #: 3098
Name: Exeter Drilling

County: Greeley
Base Name: Linn Well #: 1
Field Name: Moore-Johnson
Is this a Prorated Field? yes no
Target Formation(s): Basal Upper Morrow
Nearest lease or unit boundary: 1200'
Ground Surface Elevation: 3890 feet MSL
Domestic well within 330 feet: yes no
Municipal well within one mile: yes no
Depth to bottom of fresh water: 410' 100'
Depth to bottom of usable water: 410' 1750'
Surface Pipe by Alternate: 1 2
Length of Surface Pipe Planned to be set: 500'
Length of Conductor pipe required: _____
Projected Total Depth: 5300'
Formation at Total Depth: Mississippian
Water Source for Drilling Operations:
 well farm pond other
WR Permit #: _____
Will Cores Be Taken?: yes no
If yes, proposed zone: _____

Well Drilled For: Well Class: Type Equipment:
 Oil Inj Infield Mud Rotary
 Gas Storage Pool Ext. Air Rotary
 OWWO Disposal Wildcat Cable
 Seismic; # of Holes

If OWWO: old well information as follows:
Operator: N/A
Well Name: _____
Comp. Date: _____ Old Total Depth _____

Directional, Deviated or Horizontal wellbore? yes no
If yes, total depth location: _____

AFFIDAVIT

The undersigned hereby affirms that the drilling, completion and eventual plugging of this well will comply with K.S.A. 55-101, et. seq.

- It is agreed that the following minimum requirements will be met:
1. The appropriate district office shall be notified before setting surface pipe;
 2. The minimum amount of surface pipe as specified above shall be set by circulating cement to the top; in all cases surface pipe shall be set through all unconsolidated materials plus a minimum of 20 feet into the underlying formation;
 3. If the well is dry, a plugging proposal shall be submitted to the district office. An agreement between the operator and the district office on plug length and placement is necessary prior to plugging;
 4. The appropriate district office will be notified before well is either plugged or production casing is cemented in;
 5. If an Alternate II completion, production pipe shall be cemented from below any usable water to surface within 120 days of spud date. In all cases, notify district office prior to any cementing.
- I hereby certify that the statements made herein are true and to the best of my knowledge and belief.

Date: 9/10/90 Signature of Operator or Agent: J.L. Hampton Title: Sr. Staff Admin. Supv.

FOR KCC USE:
API # 15- 071-20524-0000
Conductor pipe required None feet
Minimum surface pipe required 320 feet per Alt. (2)
Approved by: MRW 9-21-90
EFFECTIVE DATE: 9-26-90
This authorization expires: 3-21-91
(This authorization void if drilling not started within 6 months of effective date.)
Spud date: _____ Agent: _____

80 A
150C
SEP 12 1990
9-12-90
CONSERVATION DIVISION
Wichita, Kansas
18
4310

REMEMBER TO:


- File Drill Pit Application (form CDP-1) with Intent to Drill;
- File Completion Form ACO-1 within 120 days of spud date;
- File acreage attribution plat according to field proration orders;
- Notify appropriate district office 48 hours prior to workover or re-entry;
- Submit plugging report (CP-4) after plugging is completed;
- Obtain written approval before disposing or injecting salt water.

PLAT OF ACREAGE ATTRIBUTABLE TO A WELL

State Corporation Commission, Conservation Division
 200 Colorado Derby Bldg. Wichita, Kansas 67202

OPERATOR Amoco Production Company LOCATION OF WELL:
 LEASE Linn 2130 feet north of SE corner
 WELL NUMBER 1 3255 feet west of SE corner
 FIELD Moore-Johnson SW/4 Sec. 14 T 18 R 43 ~~N/W~~
 COUNTY Greeley
 NO. OF ACRES ATTRIBUTABLE TO WELL 640 IS SECTION REGULAR X IRREGULAR?
 DESCRIPTION OF ACREAGE All IF IRREGULAR, LOCATE WELL FROM NEAREST
 CORNER BOUNDARY.

NOTE: If plat depicted is insufficient for your circumstances, you may attach your own scaled or surveyed plat.

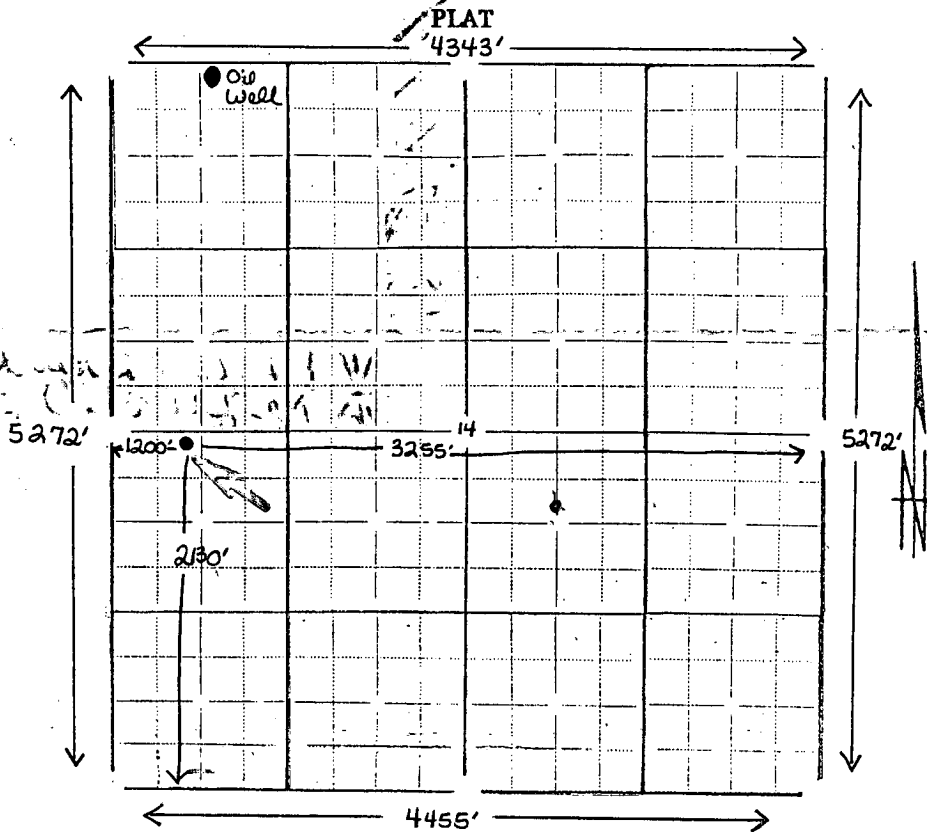

In plotting the proposed location of the well, you must show:

- 1) The manner in which you are using the depicted plat by identifying section lines, i.e. 1 section, 1 section with 8 surrounding partial sections, 4 sections, 16 sections, etc.;
- 2) the well's location relative to the location of other wells producing from the same common source of supply in adjoining drilling units, pursuant to K.A.R. 82-3-108, 82-3-207, 82-3-312, or special orders of the Commission;
- 3) the distance of the proposed drilling location from the section's east and south lines; and
- 4) the distance to the nearest lease or unit boundary line.

I hereby certify that the statements made herein are true and to the best of my knowledge and belief.

Signature of Operator or Agent J. L. Hampton
 Date 9/10/90 Title Sr. Staff Admin. Supv.