

STATE OF KANSAS
STATE CORPORATION COMMISSION

WELL PLUGGING RECORD

Give All Information Completely
Make Required Affidavit
Mail or Deliver Report to
Conservation Division
State Corporation Comm.
245 North Water
Wichita, KS 67202

Ellsworth County, Sec. 27 Twp. 14S Rge. 9 EE/W
Location as "NE/CNW/SW" or footage from lines
SW SW SW

Lease Owner Rains & Williamson Oil Co., Inc.
Lease Name Haase (WD) Well No. #1

Office Address 435 Page Court, 220 W. Douglas, Wichita, Ks.
Character of Well (Completed as Oil, Gas or Dry Hole)

Dry Hole

Date Well completed 4-29-83 19
Application for plugging filed 4-29-83 19
Application for plugging approved 4-29-83 19
Plugging commenced 4-29-83 19
Plugging completed 4-29-83 19


Reason for abandonment of well or producing formation
Commercial quantities of oil not found

If a producing well is abandoned, date of last production
19

Was permission obtained from the Conservation Division or
its agents before plugging was commenced? Yes

Name of Conservation Agent who supervised plugging of this well Gilbert Toman
Producing formation _____ Depth to top _____ Bottom _____ Total Depth of Well 1813'

Show depth and thickness of all water, oil and gas formations.

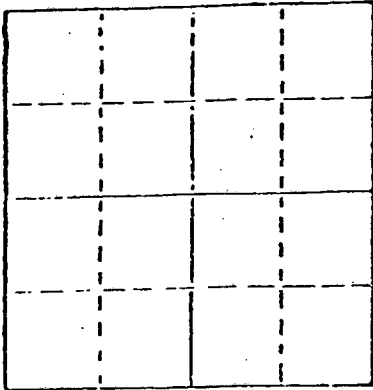

Locate well correctly on above
Section Plot

OIL, GAS OR WATER RECORDS

CASING RECORD

FORMATION	CONTENT	FROM	TO	SIZE	PUT IN	PULLED OUT
				Previously Set		

Describe in detail the manner in which the well was plugged, indicating where the mud fluid was placed and the method or methods used in introducing it into the hold. If cement or other plugs were used, state the character of same and depth placed, from _____ feet to _____ feet for each plug set.

- Plug @ 500' w/50 sx.
- Plug @ 220' w/30 sx.
- Plug @ 40' w/10 sx.
- Rat Hole 10. sx.

(If additional description is necessary, use BACK of this sheet)

Name of Plugging Contractor Rains & Williamson Oil Co., Inc.

STATE OF Kansas COUNTY OF Sedgwick, ss.
Wilson Rains, President of Rains & Williamson Oil Co., (employee of owner) or (owner or operator) of the above-described well, being first duly sworn on oath, says: That I have knowledge of the facts, statements, and matters herein contained and the log of the above-described well as filed and that the same are true and correct. So help me God.

(Signature) Wilson Rains
435 Page Court, 220 W. Douglas, Wichita, Ks. 67202
(Address)

SUBSCRIBED AND SWORN TO before me this 9 day of May, 1983

Juanita M. Green
Juanita M. Green Notary Public.

My commission expires 10-4-83



RECEIVED
STATE CORPORATION COMMISSION

MAY 12 1983

CONSERVATION DIVISION
Wichita, Kansas

15-053-20766-00-01

DRILLER'S LOG

COMPANY: Rains & Williamson Oil Co., Inc. SEC. 27 T. 14S R. 9W

LOC. SW SW SW

WELL NAME: Haase #1 (WD)

COUNTY: Ellsworth

RIG NO. #9

TOTAL DEPTH 813'

ELEVATION 1623 GL 1628 KB

COMMENCED: 4-27-83

COMPLETED: 4-29-83

CONTRACTOR: Rains & Williamson Oil Co., Inc.

CASING RECORD:

SURFACE: Previously Set

PRODUCTION: D&A

LOG

(Figures Indicate Bottom of Formations)

ROTARY TOTAL DEPTH 813

RECEIVED
STATE CORPORATION COMMISSION

MAY 12 1983

CONSERVATION DIVISION
Wichita, Kansas

STATE OF Kansas)

COUNTY OF Sedgwick)

SS:

I, Wilson Rains, President of Rains & Williamson Oil Co., Inc.
upon oath state that the above and foregoing is a true and correct copy of the log of the
Haase #1 (WD) well.

Wilson Rains
Wilson Rains



Subscribed and sworn to before me this 9 day of May, 1983.

My Appointment Expires:
10-4-83

Juanita M. Green
Juanita M. Green