


STATE OF KANSAS  
STATE CORPORATION COMMISSION

Give All Information Completely  
Make Required Affidavit  
Mail or Deliver Report to  
Conservation Division  
State Corporation Commission  
245 North Water  
Wichita, KS 67202

FORM CP-4

WELL PLUGGING RECORD

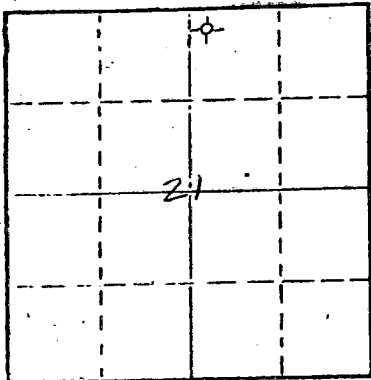

Locate well correctly on above  
Section Plot

Ellsworth County, Sec. 21 Twp. 14S Rge. 9W (X) (W)

Location as "NE/CNW/SW" or footage from lines NW NW NE

Lease Owner Mack Oil Co.

Lease Name Warttig Well No. 1

Office Address 812 Union Center, Wichita, KS 67202

Character of Well (completed as Oil, Gas or Dry Hole) dry hole

Date well completed 3-29-76 19

Application for plugging filed 4-6-76 19

Application for plugging approved 3-29-76 19

Plugging commenced 3-29-76 19

Plugging completed 3-29-76 19

Reason for abandonment of well or producing formation dry hole

If a producing well is abandoned, date of last production 19

Was permission obtained from the Conservation Division or its agents before plugging was commenced? yes

Name of Conservation Agent who supervised plugging of this well Gilbert Toman, Holyrood, KS

Producing formation \_\_\_\_\_ Depth to top \_\_\_\_\_ Bottom \_\_\_\_\_ Total Depth of Well 3465' Feet

Show depth and thickness of all water, oil and gas formations.

OIL, GAS OR WATER RECORDS

CASING RECORD

FORMATION	CONTENT	FROM	TO	SIZE	PUT IN	PULLED OUT
				8 5/8"	260'	

Describe in detail the manner in which the well was plugged, indicating where the mud fluid was placed and the method or methods used in introducing it into the hole. If cement or other plugs were used, state the character of same and depth placed, from \_\_\_\_\_ feet to \_\_\_\_\_ feet for each plug set.

RECEIVED  
STATE CORPORATION COMMISSION

APR 17 1976  
04-07-76  
CONSERVATION DIVISION  
Wichita, Kansas

Plugged @ 500' w/40 sx.  
@ 260' w/25 sx.  
@ 40' w/10 sx.  
2 sx. in rathole

(If additional description is necessary, use BACK of this sheet)  
Name of Plugging Contractor Thomas Drilling Co.  
Address P. O. Box 400, Duncan, OK 73533


STATE OF Kansas COUNTY OF Sedgwick ss.  
Harry A. Larsh (employee of owner) or (owner or operator) of the above-described

well, being first duly sworn on oath, says: That I have knowledge of the facts, statements, and matters herein contained and the log of the above-described well as filed and that the same are true and correct. So help me God.

(Signature) Harry A. Larsh  
812 Union Center, Wichita, KS 67202  
(Address)

SUBSCRIBED AND SWORN TO before me this 6th day of April, 1976

My Commission Expires Jan. 8, 1978  
Nancy Laggart  
Nancy Laggart Notary Public.

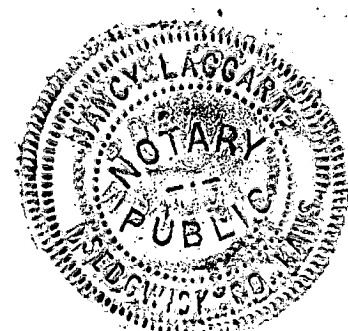

MACK OIL COMPANY  
Wichita, Kansas

DRILLERS WELL LOG

#1 Warttig

NW NW NE - Sec. 21-14S-9W  
Ellsworth County, Kansas  
Elevation: 1770' KB, 1761' GL  
Dry & Abandoned  
Contractor: Thomas Drilling Co.

Commenced R.D. 3-23-76  
Completed R.D. 3-29-76  
Rotary Total Depth: 3465'

STRATA	DEPTH
Post Rock & Clay	80
Clay & Shale	284
Shale	550
Shale & Lime	1800
Lime & Shale	2700
Lime	3465

RECEIVED  
CONSERVATION COMMISSION  
APR 07 1976  
CONSERVATION DIVISION  
Wichita, Kansas

Depth indicated bottom of formation

I hereby certify that the above is a true and correct log of said well as reflected by the daily drilling reports.

MACK OIL CO.

By Harry A. Larsh  
Harry A. Larsh

Signed and sworn to in my presence this 6th day of April, 1976, by Harry A. Larsh, representative of Mack Oil Co.

My Commission Expires Jan. 8, 1978

Nancy Laggart  
Nancy Laggart, Notary Public

