


Give All Information Completely
Make Required Affidavit
Mail or Deliver Report to:
Conservation Division
State Corporation Commission
211 No. Broadway
Wichita, Kansas

WELL PLUGGING RECORD

Ellsworth County, Sec. 8 Twp. 14S Rge. 9 (E) (W)

Location as "NE/CNW/SW" or footage from lines SW, SW $\frac{1}{4}$ of the SW $\frac{1}{4}$
Lease Owner Ehrlich Drilling Company & Bob Craig
Lease Name Louis Soukup Well No. 1
Office Address Box 173, Wilson, Kansas 67490
Character of Well (completed as Oil, Gas or Dry Hole) dry hole
Date well completed January 22, 1969 19 69
Application for plugging filed March 18, 19 69
Application for plugging approved January 21 19 69
Plugging commenced January 22 19 69
Plugging completed January 22 19 69
Reason for abandonment of well or producing formation dry hole

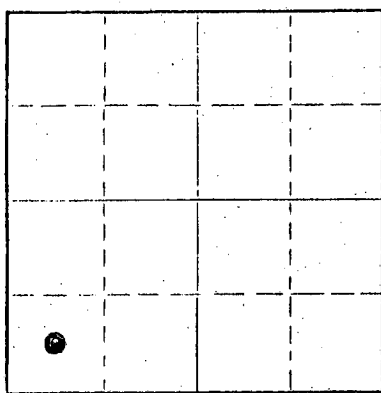

Locate well correctly on above Section Plat

If a producing well is abandoned, date of last production 19
Was permission obtained from the Conservation Division or its agents before plugging was commenced? yes

Name of Conservation Agent who supervised plugging of this well the agent from Holyrood or McPherson, Kansas
Producing formation Depth to top Bottom Total Depth of Well 2872 Feet
Show depth and thickness of all water, oil and gas formations.

OIL, GAS OR WATER RECORDS

CASING RECORD

FORMATION	CONTENT	STATE CORPORATION COMMISSION	SIZE	PUT IN	PULLED OUT
		RECEIVED FROM TO MAR 18 1969 CONSERVATION DIVISION Wichita, Kansas	8 5/8"	165 ft.	none
			cemented with 75 sacks & circulated to the surface.		

Describe in detail the manner in which the well was plugged, indicating where the mud fluid was placed and the method or methods used in introducing it into the hole. If cement or other plugs were used, state the character of same and depth placed, from feet to feet for each plug set.

Filled hole with mud to 180 feet.
Set plug at 180 feet with 25 sacks of common cement and hulls. Mud to 40 feet. Set plug at 40 feet of solid bridge and mixed and pumped 10 sacks of common cement to surface. Dumped 2 sacks of common cement in rat hole with a bridge made of hulls.

Please note: Globe Oil Well Cementing, Inc., Great Bend, Kansas 67530, as listed by their invoice number 11990, furnished the pumping equipment to plug this well. The cement was furnished by Hoch Lumber Company, Wilson, Kansas.

ALL THIS PLUGGING WAS UNDER THE SPECIFICATIONS of your District Plugging for this area.

Name of Plugging Contractor Ehrlich Drilling Company, Box 173, Wilson, Kansas 67490.
Address

STATE OF Kansas COUNTY OF Shawnee ss.
Richard B. Schmidt, geologist of (employee of owner) of the above-described well, being first duly sworn on oath, says: That I have knowledge of the facts, statements, and matters herein contained and the log of the above-described well as filed and that the same are true and correct. So help me God.

(Signature) Richard B. Schmidt
1219 College Avenue, Topeka, Kansas 66604
(Address)

Sworn to before me this 17th day of March 19 69

Barbara A. Buzen
Notary Public.



NO. 1 SOUKUP

Well Log:

Location: Ctr. SW $\frac{1}{4}$, SW $\frac{1}{4}$ of the SW $\frac{1}{4}$ of Section 8 Ellsworth County, Kansas, Township 14 South, Range 9 West Commenced: January 6, 1969

Operator: Ehrlich Drilling Company & Bob Craig Completed: January 22, 1969
P. O. Box 173 (Rotary)
Wilson, Kansas

Contractor: Ehrlich Drilling Company Elevation: 1701 K. B.
P. O. Box 173
Wilson, Kansas 67490 Production: D & A

Casing Record: 8 - 5/8th inch @ 165 feet with 75 sacks of common cement.

- * * * L O G * * * -

(Figures indicate bottom of formation)

Clay	40	Sandy lime & shale	
Sand	50	Lime	2180
Shale & Clay	190	Shale	2220
Red Bed	287	Lime & shale	2410
Red Bed & Shale	390	Lime	2520
Iron Sulphate	410	Shale	2570
Clay & Shale	550	Lime	2625
Shale, Shells		Shale	2635
Salt	970	Lime	2700
Sale & Salt	1125	Shale	2704
Anhydrite	1280	Lime & Shale	2740
Shale	1315	Sand & sandy shale	2805
Sandy lime & Shale	1470	Limy shale	2820
Lime	1605	Lime & Shale	2840
Lime & Shale	1625	Lime	2872 R. T. D.
Lime	1810		
Lime	1945		
Lime & Shale	2090		

Please note: No formation tops are being released at this time.

The undersigned, EHRlich DRILLING COMPANY & BOB CRAIG, hereby certify that the above log is a true and correct log of the formations encountered in drilling the above well as reflected by the Daily Drilling reports.

EHRlich DRILLING COMPANY & BOB CRAIG,

STATE OF KANSAS)
) ss.
COUNTY OF SHAWNEE)

By: Richard B. Schmidt, geologist for
Richard B. Schmidt
Julius Ehrlich, Tom Ehrlich, Bob Craig,
Operator

Subscribed and sworn to before me
this 17th day of March, 1969.

By: *Barbara D. Bungen*
Notary Public

My commission expires: January 31, 1971

