


STATE OF KANSAS
STATE CORPORATION COMMISSION

Give All Information Completely
Make Required Affidavit
Mail or Deliver Report to
Conservation Division
State Corporation Commission
245 North Water
Wichita, KS 67202

FORM CP-4

WELL PLUGGING RECORD

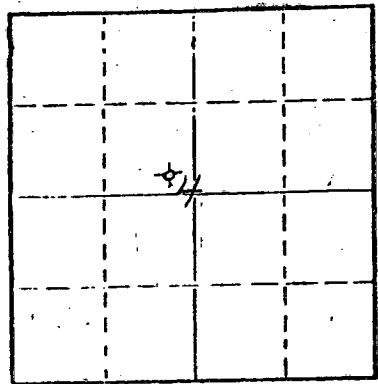

Locate well correctly on above
Section Plot

Ellsworth County, Sec. 4 Twp. 14 Rge. 9 (S) (W)
Location as "NE/CNW/SW" or footage from lines SE SE NW
Lease Owner Mack Oil Co.
Lease Name Weinhold Well No. 1
Office Address 812 Union Center, Wichita, KS 67202
Character of Well (completed as Oil, Gas or Dry Hole) dry hole
Date well completed 4-9-76 19
Application for plugging filed 4-12-76 19
Application for plugging approved 4-9-76 19
Plugging commenced 4-9-76 19
Plugging completed 4-9-76 19
Reason for abandonment of well or producing formation dry hole

If a producing well is abandoned, date of last production 19
Was permission obtained from the Conservation Division or its agents before plugging was commenced? yes

Name of Conservation Agent who supervised plugging of this well Gilbert Toman, Holyrood, KS
Producing formation _____ Depth to top _____ Bottom _____ Total Depth of Well 3476 Feet
Show depth and thickness of all water, oil and gas formations.

OIL, GAS OR WATER RECORDS				CASING RECORD		
FORMATION	CONTENT	FROM	TO	SIZE	PUT IN	PULLED OUT
				8 5/8"	266'	

Describe in detail the manner in which the well was plugged, indicating where the mud fluid was placed and the method or methods used in introducing it into the hole. If cement or other plugs were used, state the character of same and depth placed, from _____ feet to _____ feet for each plug set.

RECEIVED
STATE CORPORATION COMMISSION

APR 13 1976
04-13-76
CONSERVATION DIVISION
Wichita, Kansas

Plugged @ 500' w/35 sx. cement.
@ 250' w/25 sx.
@ 40' w/10 sx.
2 sx. in rathole

(If additional description is necessary, use BACK of this sheet)
Name of Plugging Contractor Thomas Drilling Co.
Address P. O. Box 400, Duncan, OK 73533


STATE OF Kansas COUNTY OF Sedgwick ss.
Harry A. Larsh (employee of owner) or (owner or operator) of the above-described

well, being first duly sworn on oath, says: That I have knowledge of the facts, statements, and matters herein contained and the log of the above-described well as filed and that the same are true and correct. So help me God.

(Signature) Harry A. Larsh
812 Union Center, Wichita, KS 67202
(Address)

SUBSCRIBED AND SWORN TO before me this 12th day of April, 1976

My Commission Expires Jan. 8, 1978
Nancy Laggart
Nancy Laggart, Notary Public.

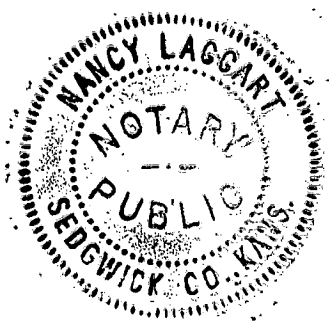

MACK OIL COMPANY
Wichita, Kansas

DRILLER'S WELL LOG

#1 Weinhold		SE SE NW - Sec. 4-14S-9W
		Ellsworth County, Kansas
Commenced R.D.	4-2-76	Elevation: 1761' KB, 1752' GL
Completed R.D.	4-9-76	Dry & Abandoned
Rotary Total Depth:	3476'	Contractor: Thomas Drilling Co.

<u>STRATA</u>	<u>DEPTH</u>
Clay	40
Post Rock & Shale	745
Shale	1510
Lime & Shale	3476'

DEPTH INDICATED BOTTOM OF FORMATIONS

I hereby certify that the above is a true and correct log of said well as reflected by the daily drilling reports.

MACK OIL CO.

Harry A. Larsh
Harry A. Larsh

RECEIVED
STATE OF KANSAS CONSERVATION COMMISSION

APR 13 1976

CONSERVATION DIVISION
Wichita, Kansas

Signed and sworn to in my presence this 12th day of April, 1976, by Harry A. Larsh, representative of Mack Oil Co.

My Commission Expires Jan. 8, 1978

Nancy Laggart
Nancy Laggart, Notary Public

