

STATE OF KANSAS
STATE CORPORATION COMMISSION


WELL PLUGGING RECORD

OR
FORMATION PLUGGING RECORD

Strike out upper line
when reporting plugging
off formations.

Give All Information Completely
Make Required Affidavit
Mail or Deliver Report to:
Conservation Division
State Corporation Commission
800 Bitting Building
Wichita, Kansas

NORTH

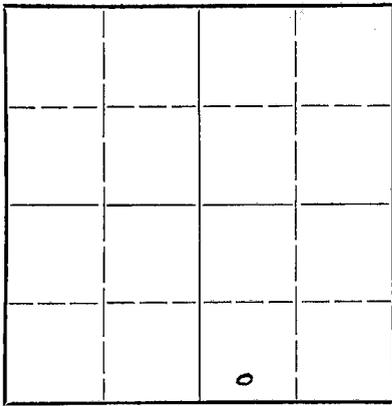

Locate well correctly on above
Section Plat

Scott County. Sec. 10 Twp. 20 Rge. (E) 33 (W)
Location as "NE $\frac{1}{4}$ NW $\frac{1}{4}$ SW $\frac{1}{4}$ " or footage from lines. C S $\frac{1}{2}$ SW $\frac{1}{4}$ SE $\frac{1}{4}$
Lease Owner. The Shallow Water Refining Company
Lease Name. Roark Well No. 2
Office Address. 114 West Pine St., Garden/City, Kansas
Character of Well (completed as Oil, Gas or Dry Hole). Oil
Date well completed. February 27, 1945
Application for plugging filed. January 8, 1951
Application for plugging approved. January 10, 1951
Plugging commenced. February 21, 1951
Plugging completed. April 18, 1951
Reason for abandonment of well or producing formation. Non-commercial

If a producing well is abandoned, date of last production. September 3, 1947
Was permission obtained from the Conservation Division or its agents before plugging was commenced? Yes

Name of Conservation Agent who supervised plugging of this well. C. D. Stough
Producing formation. Mississippi Depth to top 4619 Bottom - Total Depth of Well 4670 Feet
Show depth and thickness of all water, oil and gas formations.

OIL, GAS OR WATER RECORDS

CASING RECORD

Formation	Content	From	To	Size	Put In	Pulled Out
Mississippi	Lime	4619	-	5 $\frac{1}{2}$ "	4619'	1280'

Describe in detail the manner in which the well was plugged, indicating where the mud fluid was placed and the method or methods used in introducing it into the hold. If cement or other plugs were used, state the character of same and depth placed, from.....feet to.....feet for each plug set.

Lane-Wells plug set at 4070'. Perforated from 3958' to 3966'.

Filled hole with coarse sand from 4070' to 3950'.

Dumped 5 sacks cement.

Mudded hole to 253'.

Set 10' rock bridge.

Ran 15 sacks cement.

Mudded hole to 20'.

Ran 10 sacks cement.

(If additional description is necessary, use BACK of this sheet)

Correspondence regarding this well should be addressed to The Shallow Water Refining Company
Address. 114 West Pine St.,
Garden City, Kansas

STATE OF ~~KANSAS~~ COUNTY OF ~~FINNEY~~
Ben L. Kelley (employee of owner) of the above-described well,

being first duly sworn on oath, says: That I have knowledge of the facts, statements, and matters herein contained and the log of the above-described well as filed and that the same are true and correct to the best of my knowledge and belief.

(Signature) Ben L. Kelley

APR 27 1951
CONSERVATION DIVISION
Wichita, Kansas Garden City, Kansas
(Address)

SUBSCRIBED AND SWORN TO before me this 26th day of April 19 51

Catherine Petersen
Notary Public.

My commission expires June 1, 1953

PLUGGING
FILE SEC-10T-20-R33
BOOK PAGE 54 LINE 7

