


WELL PLUGGING RECORD

Give All Information Completely  
Make Required Affidavit  
Mail or Deliver Report to:  
Conservation Division  
State Corporation Commission  
211 No. Broadway  
Wichita, Kansas

Scott County. Sec. 7 Twp. 20S Rge. 33 (E) W (W)  
CSW/4 SW/4

Location as "NE/CNW/SW" or footage from lines \_\_\_\_\_  
Lease Owner Cities Service Oil Co.  
Lease Name Rothfelder Well No. 1  
Office Address 1107 N. Kansas Avenue, Liberal, Kansas 67901  
Character of Well (completed as Oil, Gas or Dry Hole) Oil Well - SWD Well  
Date well completed \_\_\_\_\_ 19 \_\_\_\_  
Application for plugging filed 10/10/ 19 69  
Application for plugging approved \_\_\_\_\_ 19 \_\_\_\_  
Plugging commenced 10/27 19 69  
Plugging completed 10/31 19 69  
Reason for abandonment of well or producing formation \_\_\_\_\_

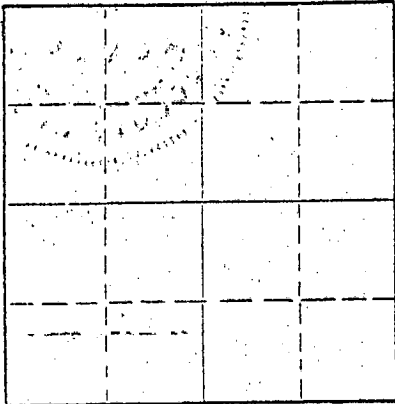

Locate well correctly on above Section Plat

If a producing well is abandoned, date of last production \_\_\_\_\_ 19 \_\_\_\_  
Was permission obtained from the Conservation Division or its agents before plugging was commenced? \_\_\_\_\_

Name of Conservation Agent who supervised plugging of this well \_\_\_\_\_  
Producing formation \_\_\_\_\_ Depth to top \_\_\_\_\_ Bottom \_\_\_\_\_ Total Depth of Well \_\_\_\_\_ Feet  
Show depth and thickness of all water, oil and gas formations.

OIL, GAS OR WATER RECORDS

CASING RECORD

FORMATION	CONTENT	FROM	TO	SIZE	PUT IN	PULLED OUT
				9 5/8 5 1/2	376 4870	0 1606

RECEIVED  
STATE CORPORATION COMMISSION  
NOV 21 1969  
CONSERVATION DIVISION  
Wichita, Kansas

Describe in detail the manner in which the well was plugged, indicating where the mud fluid was placed and the method or methods used in introducing it into the hole. If cement or other plugs were used, state the character of same and depth placed, from \_\_\_\_\_ feet to \_\_\_\_\_ feet for each plug set.

Mix 25 sks. cement and squeeze off perfs at 4,044'  
Mix 5 sks. hulls and 8 sks. gell. Pump 125 sks. cement at 1,000' to 600';  
5 sks. gell at 600' to 400'; 25 sks. cement at 400' to 320'; 5 sks. gell  
at 320' to 40'; pump 10 sks. cement at 40' to cellar.

(If additional description is necessary, use BACK of this sheet)


Name of Plugging Contractor Sargent Casing Pulling Service  
Address Box 506, Liberal, Kansas 67901

STATE OF KANSAS, COUNTY OF SEWARD, ss.  
Robert Sargent (owner or operator) of the above-described

has being duly sworn on oath, says: That I have knowledge of the facts, statements, and matters herein contained and the log of the well as filed and that the same are true and correct. So help me God.

(Signature) Robert Sargent  
Box 506, Liberal, Kansas 67901  
(Address)

sworn to before me this 13th day of November, 19 69  
My Commission Expires Jan. 22, 1973

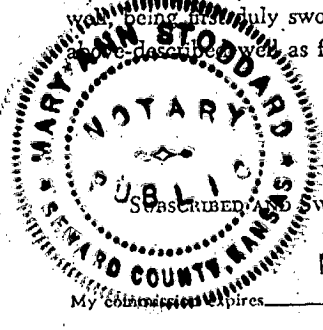

Mary Ann Stoddard  
Notary Public.