


15-007-20254-0000

Form CP-4

STATE OF KANSAS
STATE CORPORATION COMMISSION

WELL PLUGGING RECORD

All Information Completely
Made Required Affidavit
Filed or Return Report to
Conservation Division
State Corporation Commission
P. O. Box 17027
Wichita, Kansas 67217

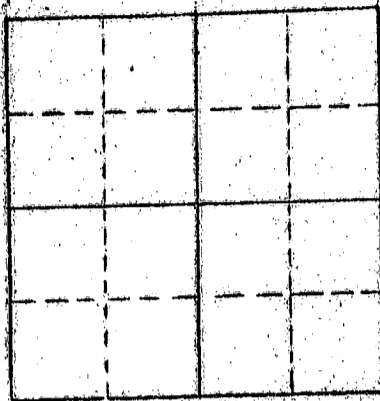

Locate well correctly on above
Section Plat

Barber County, Sec. 28 Twp. 32S. Rge. (E) 13(W)
C NE SW
Location as "NE/CNW/SE/SW" or footage from lines _____
Lease Owner Kedco Drilling Partnership 1973-A
Lease Name Hopkins Well No. 1
Office Address 816 Union Center, Wichita, Kansas 67202
Character of Well (completed as Oil, Gas or Dry Hole) Dry Hole
Date well completed April 2, 1974
Application for plugging filed April 2, 1974
Application for plugging approved April 2, 1974
Plugging commenced April 2, 1974
Plugging completed April 2, 1974
Reason for abandonment of well or producing formation _____

If a producing well is abandoned, date of last production _____ 19____
Was permission obtained from the Conservation Division or its agents before plugging was commenced? Yes

Name of Conservation Agent who supervised plugging of this well G. R. Biberstein
Producing formation _____ Depth to top _____ Bottom _____ Total Depth of Well 3920 Feet
Show depth and thickness of all water, oil and gas formations.

OIL, GAS OR WATER RECORDS

'CASING RECORD'

FORMATION	CONTENT	FROM	TO	SIZE	PUT IN	PULLED OUT

Describe in detail the manner in which the well was plugged, indicating where the mud fluid was placed and the method or methods used in introducing it into the hole. If cement or other plugs were used, state the character of same and depth placed, from _____ feet to _____ feet for each plug set.

Pushed plug and 1/2 sack hulls to 250 feet. Cemented with 250 sacks cement. Mudded up with heavy mud to 40 feet followed by wooden plug, 1/2 sack hulls and 10 sacks cement to base of well cellar. Plugged rat hole with 2 sacks cement

RECEIVED
STATE CORPORATION COMMISSION
APR 9 - 9 - 1974
CONSERVATION DIVISION
Wichita, Kansas


(If additional description is necessary, use BACK of this sheet)
Name of Plugging Contractor Graves Drilling Co., Inc.
Address 505 Union Center, Wichita, Kansas 67202

STATE OF KANSAS COUNTY OF SEDGWICK ss.
John C. Graves (employen of owner) or (owner or oprctor) of the above-described

well, being first duly sworn on oath, says: That I have knowldgo of the facts, statements, and matters herein contained and the log of the above-described well as filed and that the same are true and correct. So help me God.

(Signature) John C. Graves
505 Union Center, Wichita, Kansas 67202
(Address)

Subscribed and sworn to before me this 8th day of April 1974

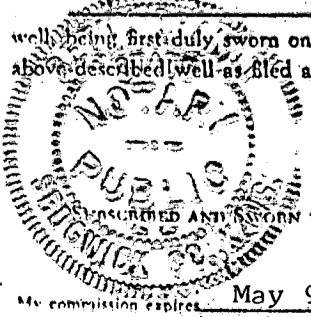

Betty Brandt
Betty Brandt
Notary Public.

15-007-20254-0000

ROTARY DRILLERS' LOG

OPERATOR: Kedco Drilling Partnership 1973-A DRILLING COMMENCED: March 25, 1974
816 Union Center
Wichita, Kansas 67202

CONTRACTOR: Graves Drilling Co., Inc. DRILLING COMPLETED: April 2, 1974
505 Union Center
Wichita, Kansas 67202

CASING RECORD: 9 Jts. 321' 8-5/8" cemented with 250 sacks.
LOCATION: Hopkins No. 1
C NE SW
Section 28-32S-13W
Barber County, Kansas

0 - 764 Red Bed
764 - 1190 Red bed & shale
1190 - 1360 Shale
1360 - 1500 Shale & shells
1500 - 1740 Shale & lime
1740 - 1920 Lime & shale
1920 - 2239 Lime
2239 - 3131 Lime & shale
3131 - 3450 Shale & lime
3450 - 3500 Lime & shale
3500 - 3677 Shale & lime
3677 - 3869 Lime & shale
3869 - 3920 Sand
3920 Rotary Total Depth

RECEIVED
STATE CORPORATION COMMISSION
APR 9 - 1974
CONSERVATION DIVISION
Wichita, Kansas

I hereby certify the foregoing statements to be true and correct to the best of my knowledge.

GRAVES DRILLING CO., INC.

By John Graves
President

STATE OF KANSAS)
SEDEWICK COUNTY)

ss.

Subscribed and sworn to before me, a Notary Public, this 8th of April, 1974.

My commission expires:

Betty Brandt
Betty Brandt Notary Public

My 9, 1974