


Give All Information Completely  
Make Required Affidavit  
Mail or Deliver Report to:  
Conservation Division  
State Corporation Commission  
800 Bittling Building  
Wichita, Kansas

WELL PLUGGING RECORD

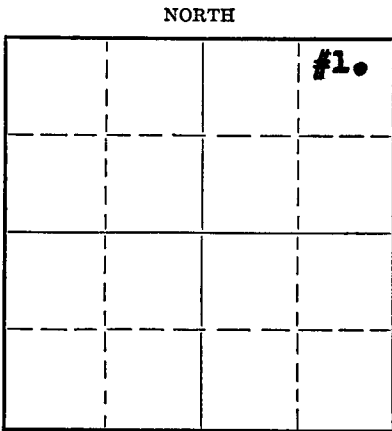

Locate well correctly on above Section Plat

Scott County. Sec. 5 Twp. 18S Rge. (E) 32 (W)  
Location as "NE/CNW $\frac{1}{4}$ SW $\frac{1}{4}$ " or footage from lines Center of NE $\frac{1}{4}$  at NE $\frac{1}{4}$  of NE $\frac{1}{4}$   
Lease Owner Amerada Pet. Corp.  
Lease Name Joseph Petrzalka Well No. 1  
Office Address Box 2040, Tulsa, Okla.  
Character of Well (completed as Oil, Gas or Dry Hole) Dry Hole.  
Date well completed May 18, 19 51  
Application for plugging filed May 19, 19 51  
Application for plugging approved May 19, 19 51  
Plugging commenced May 19, 19 51  
Plugging completed May 19, 19 51  
Reason for abandonment of well or producing formation Dry Hole.

If a producing well is abandoned, date of last production \_\_\_\_\_ 19\_\_\_\_  
Was permission obtained from the Conservation Division or its agents before plugging was commenced? Yes

Name of Conservation Agent who supervised plugging of this well Mr. Merl Rives of Great Bend, Kans.  
Producing formation \_\_\_\_\_ Depth to top \_\_\_\_\_ Bottom \_\_\_\_\_ Total Depth of Well 4140' Feet  
Show depth and thickness of all water, oil and gas formations.

OIL, GAS OR WATER RECORDS

CASING RECORD

Formation	Content	From	To	Size	Put In	Pulled Out
				<u>9-5/8" OD</u>	<u>284'</u>	<u>None.</u>

Describe in detail the manner in which the well was plugged, indicating where the mud fluid was placed and the method or methods used in introducing it into the hole. If cement or other plugs were used, state the character of same and depth placed, from \_\_\_\_\_ feet to \_\_\_\_\_ feet for each plug set.

Filled hole with heavy rotary mud up to 270' down from top, set bridge plug at 270' down from top, mixed & poured in 20 sacks of regular cement through 4 1/2" drill pipe on top of plug. Filled hole with heavy rotary mud to within 35' of top of 9-5/8" surface casing in bottom of cellar, set bridge plug, dumped in 10 sacks of regular cement in hole on plug, filling hole to top of 9-5/8" surface casing in bottom of cellar as required by State Plugger Mr. Merl Rives of Great Bend, Kansas. Well plugged & abandoned at 6:15 P.M. 5/19/51.


(If additional description is necessary, use BACK of this sheet)

Correspondence regarding this well should be addressed to Amerada Pet. Corp.  
Address Box 2040  
Tulsa, Oklahoma

STATE OF Oklahoma, COUNTY OF Tulsa, SS. C. N. Rove (employee of owner) or (owner or operator) of the above-described well, being first duly sworn on oath, says: That I have knowledge of the facts, statements, and matters herein contained and the log of the above-described well as filed and that the same are true and correct. So help me God.  
(Signature) [Signature]

SUBSCRIBED AND SWORN to before me this 25 day of May, 1951  
(Address) Riverview  
Notary Public.

My commission expires January 17, 1955

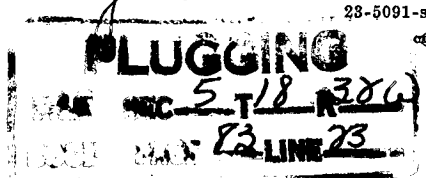

23-5091-s 8-50-10M

5-26-51

15-171-00031-0000

Well No. 1  
 Farm Joseph Petrzelka  
 Elevation 2986' D.F.  
 Location 330' South of North line  
 330' West of East line  
 Section 5-18S-32W  
 Scott County, Kansas  
 Company Amerada Petroleum Corporation  
 Commenced Drlg. 5/2/51  
 Completed Drlg. 5/18/51  
 Contractor Herndon Drilling Company  
 Initial Production Dry Hole

CASING RECORD:	SIZE	WEIGHT	FEET	CEMENT	PERFORATIONS
	9-5/8"	36#	284	275 Sacks	None

FORMATION:

Shale & Shells	0	285
Shale	285	1245
Shale & Shells	1245	1895
Shale & Salt	1895	2250
Shells	2250	2385
Shale & Shells	2385	2665
Lime	2665	3270
Lime & Shale	3270	3310
Lime	3310	3350
Lime & Shale	3350	3430
Lime	3430	3590
Lime & Shale	3590	3635
Lime	3635	3725
Lime & Shale	3725	3808
Lime	3808	4140
TOTAL DEPTH		4140'

GEOLOGICAL TOPS

Herrington	2766'
Krider	2809'
Winfield	2861'
Ft. Riley	2901'
Lansing	2966'

SCHLUMBERGER TOPS

2804'
2853'
2911'
2954'
Upper Lansing 3981'
Lower Lansing 4018'

Rotary tools used from 0 4140'

**PLUGGING**  
 FILE SEC 5 T 18 R 326  
 BOOK PAGE 83 LINE 13