


STATE OF KANSAS  
STATE CORPORATION COMMISSION

Form CP-4

Give All information Completely  
Make Required Affidavit  
Mail or Deliver Report to:  
Conservation Division  
State Corporation Commission  
P. O. Box 17027  
Wichita, Kansas 67217  
NORTH

WELL PLUGGING RECORD

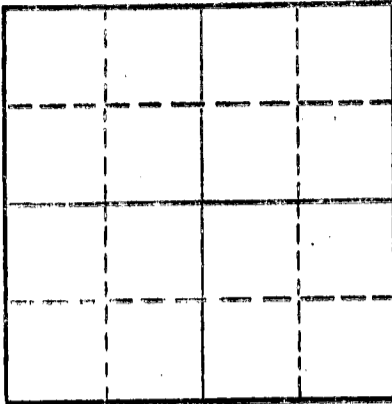

Locate well correctly on above  
Section Plat

Location as "NE/CNW/SE" or "footage from lines" \_\_\_\_\_  
Scott County, Sec. 7 Twp. 18W Rge. 32W (E) (W)  
Lease Owner: Car-Ren, Inc.  
Lease Name: Young Well No. 1-7  
Office Address: 645 R. H. Garvey Bldg.  
Character of Well (completed as Oil, Gas or Dry Hole) Dry  
Date well completed 11-4-76 19  
Application for plugging filed 11-4-76 19  
Application for plugging approved 11-4-76 19  
Plugging commenced 11-4-76 19  
Plugging completed 11-4-76 19  
Reason for abandonment of well or producing formation \_\_\_\_\_

If a producing well is abandoned, date of last production \_\_\_\_\_ 19  
Was permission obtained from the Conservation Division or its agents before plugging was commenced? Yes

Name of Conservation Agent who supervised plugging of this well S. P. Mays  
Producing formation \_\_\_\_\_ Depth to top \_\_\_\_\_ Bottom \_\_\_\_\_ Total Depth of Well \_\_\_\_\_ Feet  
Show depth and thickness of all water, oil and gas formations.

OIL, GAS OR WATER RECORDS

CASING RECORD

FORMATION	CONTENT	FROM	TO	SIZE	PUT IN	PULLED OUT

Describe in detail the manner in which the well was plugged, indicating where the mud fluid was placed and the method or methods used in introducing it into the hole. If cement or other plugs were used, state the character of same and depth placed, from \_\_\_\_\_ feet to \_\_\_\_\_ feet for each plug set.

1st @ 1050 w/70 Sax Posmix 2/6  
2nd @ 300 w/20  
40 @ w/10 sax  
5 rat hole  
Complete @ 7:30 p.m 11-5-76

FILED  
FEB 22 1977  
9-22-77  
Conservation Division

(If additional description is necessary, use BACK of this sheet)  
Name of Plugging Contractor: Gabbert-Jones, Inc.  
Address: 830 Sutton Place - Wichita, Ks. 67202

STATE OF Kansas, COUNTY OF Sedgwick, ss.  
\_\_\_\_\_, (employee of owner) or (owner or operator) of the above-described well, being first duly sworn on oath, says: That I have knowledge of the facts, statements, and matters herein contained and the log of the above-described well as filed and that the same are true and correct. So help me God.

(Signature) James S. Sutton II  
830 Sutton Place  
Wichita, Ks. 67202

SUBSCRIBED AND SWORN TO before me this 11th day of February, 1977

Elizabeth J. Edwards  
Notary Public

My commission expires 2-6-79

GABBERT-JONES, INC.  
WICHITA, KANSAS  
DRILLERS' WELL LOG

15-171-20111-0000

Young #1-7  
C-NE/4 Sec 7-18S-32W  
Scott County Kansas

Commenced: 10-20-76

Completed: 11-4-76

OPERATOR: CAR-REN INC.

Depth	Formation	Remarks
From 0	Surface Clay-Sand	Ran 9 jts of 8 5/8" csg
to 375	Shale	set @ 265' Cemented w/
375		265 sks Common 2% Gel
2616	Lime-Shale	3% CC - 1/4# Floseal
		PD @ 7:30 p.m. 10-30-76


2880 - T D

DRY & ABANDONED

STATE OF KANSAS )  
                          ) SS  
COUNTY OF SEDGWICK)

I, the undersigned, being duly sworn on oath, state that the above Drillers Log is true and correct to the best of my knowledge and belief and according to the records of this office.

GABBERT-JONES, INC.

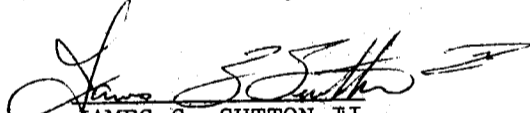  
JAMES S. SUTTON II

Subscribed and sworn to before me this 10th day of November, 1976.

  
ELIZABETH J. EDWARDS-NOTARY PUBLIC

My Commission expires February 6, 1979.



FEB 01 1977