

15-169-20092-0000


STATE OF KANSAS
STATE CORPORATION COMMISSION

WELL PLUGGING RECORD

Give All Information Completely
Make Required Affidavit
Mail or Deliver Report to
Conservation Division
State Corporation Comm.
245 North Water
Wichita, KS 67202

Saline County. Sec. 29 Twp. 15S Rge. 5W E/W
Location as "NE/CNW/SW" or footage from lines
C SW SW

Lease Owner Bass Enterprises Production Company
Lease Name Bettenbrock Well No. 1
Office Address 209 E. William, Suite 930, Wichita, Ks. 67202
Character of Well (Completed as Oil, Gas or Dry Hole) _____

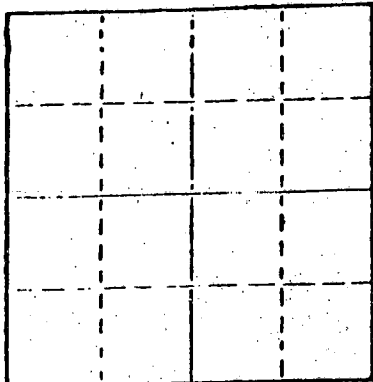

Locate well correctly on above
Section Plat

Dry Hole
Date Well completed 12/2/78 19
Application for plugging filed 12/2/78 19
Application for plugging approved 12/2/78 19
Plugging commenced 12/2/78 19
Plugging completed 12/2/78 19
Reason for abandonment of well or producing formation _____

Dry Hole
If a producing well is abandoned, date of last production _____ 19

Was permission obtained from the Conservation Division or its agents before plugging was commenced? Yes

Name of Conservation Agent who supervised plugging of this well Gilbert Toman
Producing formation _____ Depth to top _____ Bottom _____ Total Depth of Well 1800'GL
Show depth and thickness of all water, oil and gas formations.

OIL, GAS OR WATER RECORDS

CASING RECORD

FORMATION	CONTENT	FROM	TO	SIZE	PUT IN	PULLED OUT

Describe in detail the manner in which the well was plugged, indicating where the mud fluid was placed and the method or methods used in introducing it into the hold. If cement or other plugs were used, state the character of same and depth placed, from _____ feet to _____ feet for each plug set.

Drilling mud to 210', 1/2 sx hulls, 15 sx cement, mud to 40', hulls, 5 sx cement

(If additional description is necessary, use BACK of this sheet)

Name of Plugging Contractor B & N Drilling, Division of Benson Mineral Group, Inc.

STATE OF KANSAS COUNTY OF MONTGOMERY, ss. Lucille Shukers contractor (employee of ~~xxxxxx~~) or (~~xxxxxx~~) of the above-described well, being first duly sworn on oath, says: That I have knowledge of the facts, statements, and matters herein contained and the log of the above-described well as filed and that the same are true and correct. So help me God.

(Signature) Lucille Shukers
Box 846, Independence, Ks. 67301
(Address)

SUBSCRIBED AND SWORN TO before me this 2nd day of December, 1978

Jane L. McTickle
Notary Public.
My commission expires 9/24/82



KANSAS DRILLERS LOG

API No. 15 — 169 — 20,092-0000
 County Number

S. 29 T. 15S R. 5W E

Loc. C-SW SW


Operator
 Bass Enterprises Production Company

County Saline

Address
 209 East William, Suite 930, Wichita, Kansas 67202

640 Acres
 N

Well No. 1 Lease Name Bettenbrock

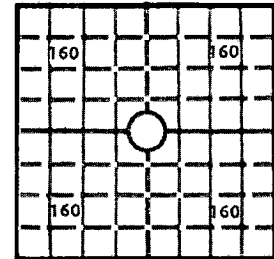

Locate well correctly

Elev.: Gr. 1530

Footage Location
 feet from (N) (S) line feet from (E) (W) line

Principal Contractor B & N Drilling Geologist Jerry Jespersen

Spud Date 11/27/78 Total Depth 1800 GL P.B.T.D.

Date Completed 12/2/78 Oil Purchaser

DF KB 1530

CASING RECORD

Report of all strings set — surface, intermediate, production, etc.

Purpose of string	Size hole drilled	Size casing set (in O.D.)	Weight lbs./ft.	Setting depth	Type cement	Sacks	Type and percent additives
Surface	9-7/8"	7"		214	Common	100	3% C.C.
Production	6 1/2"	None					

LINER RECORD

PERFORATION RECORD

Top, ft.	Bottom, ft.	Sacks cement	Shots per ft.	Size & type	Depth interval

Size	Setting depth	Packer set at

ACID, FRACTURE, SHOT, CEMENT SQUEEZE RECORD

Amount and kind of material used	Depth interval treated

RECEIVED
 STATE CORPORATION COMMISSION
 DEC 13 1978
 CONSERVATION DIVISION
 Wichita, Kansas

INITIAL PRODUCTION

Date of first production 12/2/78 P&A	Producing method (flowing, pumping, gas lift, etc.)		
RATE OF PRODUCTION PER 24 HOURS	Oil bbls.	Gas MCF	Water bbls.
Disposition of gas (vented, used on lease or sold)		Producing interval (s)	

INSTRUCTIONS: As provided in KCC Rule 82-2-125, within 90 days after completion of a well, one completed copy of this Drillers Log shall be transmitted to the State Geological Survey, of Kansas, 4150 Monroe Street, Wichita, Kansas 67209. Copies of this form are available from the Conservation Division, State Corporation Commission, 3830 So. Meridian (P.O. Box 17027), Wichita, Kansas 66217. Phone AC 316-522-2206. If confidential custody is desired, please note Rule 82-2-125. Drillers Logs will be on open file in the Oil and Gas Division, State Geological Survey of Kansas, Lawrence, Kansas 66044.

Operator
Bass Enterprises Production Company

DESIGNATE TYPE OF COMP.: OIL, GAS,
 DRY HOLE, SWDW, ETC.:

Well No. **1** Lease Name **Bettenbrock**

Dry Hole - P&A

S 29 T 15S R 5W ^E/_W

WELL LOG

Show all important zones of porosity and contents thereof; cored intervals, and all drill-stem tests, including depth interval tested, cushion used, time tool open, flowing and shut-in pressures, and recoveries.

SHOW GEOLOGICAL MARKERS, LOGS RUN, OR OTHER DESCRIPTIVE INFORMATION.

FORMATION DESCRIPTION, CONTENTS, ETC.	TOP	BOTTOM	NAME	DEPTH
soil	0	6		
clay	4	30		
shale	30	78		
lime	78	89		
shale/lime	89	98		
shale	98	144		
shale/lime	144	148		
shale/Anhydrite	148	694		
shale/lime	694	713		
shale	713	741		
lime	741	745		
shale/lime	745	748		
lime/shale	748	772		
lime	772	776		
lime/shale	776	892		
shale	892	931		
lime/shale	931	1079		
lime	1079	1094		
lime/shale	1094	1149		
lime	1149	1257		
lime/shale	1257	1319		
shale	1319	1324		
lime/shale	1324	1342		
shale	1342	1351		
lime/shale	1351	1487		
lime	1487	1500		
lime/shale	1500	1623		
shale/lime	1623	1638		
lime	1638	1670		
lime/shale	1670	1728		
lime	1728	1737		
lime/shale	1737	1790		
shale	1790	1800		

USE ADDITIONAL SHEETS, IF NECESSARY, TO COMPLETE WELL RECORD.

Date Received: _____

Ashby W. Cook
 A.W. Signature Cook
 Area Superintendent
 Title
 December 8, 1978
 Date