


Give All Information Completely  
Make Required Affidavit  
Mail or Deliver Report to:  
Conservation Division  
State Corporation Commission  
211 No. Broadway  
Wichita, Kansas

WELL PLUGGING RECORD

NORTH

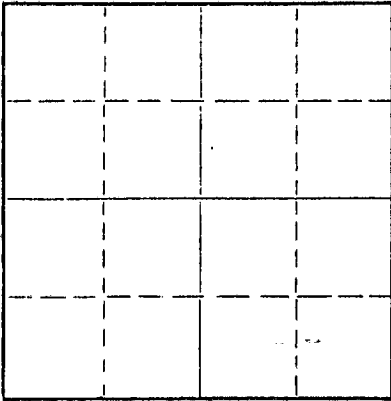

Locate well correctly on above  
Section Plat

Saline County. Sec. 36 Twp. 15 Rge. 4 (E) W (W)  
Location as "NE/CNW/SW" or footage from lines C N/2 N/2 SW/4  
Lease Owner Fender Pipe & Supply, Inc.  
Lease Name Burk Well No. 5  
Office Address Russell, Kansas  
Character of Well (completed as Oil, Gas or Dry Hole) \_\_\_\_\_  
Date well completed \_\_\_\_\_ 19\_\_\_\_  
Application for plugging filed \_\_\_\_\_ 19\_\_\_\_  
Application for plugging approved \_\_\_\_\_ 19\_\_\_\_  
Plugging commenced 6-1-66 19\_\_\_\_  
Plugging completed 6-4-66 19\_\_\_\_  
Reason for abandonment of well or producing formation Depleted.

If a producing well is abandoned, date of last production \_\_\_\_\_ 19\_\_\_\_  
Was permission obtained from the Conservation Division or its agents before plugging was commenced? yes

Name of Conservation Agent who supervised plugging of this well Gilbert Toman  
Producing formation \_\_\_\_\_ Depth to top \_\_\_\_\_ Bottom \_\_\_\_\_ Total Depth of Well 3438 Feet  
Show depth and thickness of all water, oil and gas formations.

OIL, GAS OR WATER RECORDS

CASING RECORD

FORMATION	CONTENT	FROM	TO	SIZE	PUT IN	PULLED OUT
				8-5/8"	342'	None
				5-1/2"	3437'	2856'

Describe in detail the manner in which the well was plugged, indicating where the mud fluid was placed and the method or methods used in introducing it into the hole. If cement or other plugs were used, state the character of same and depth placed, from \_\_\_\_\_ feet to \_\_\_\_\_ feet for each plug set.

Checked hole to 3438', sanded hole to 3400' and dumped 5 sacks of cement @ 3400' with dump bailer. Pulled 5 1/2" casing, set rock bridge from 260' to 250' and dumped 20 sacks of cement. Mudded hole to 30', set rock bridge and capped well with 10 sacks of cement.

PLUGGING COMPLETE.

RECEIVED  
STATE CORPORATION COMMISSION

JUN 22 1966

6-22-66

CONSERVATION DIVISION

Name of Plugging Contractor KNIGHT CASING PULLING COMPANY (If additional description is necessary, use BACK of this sheet) Wichita, Kansas  
Address CHASE, KANSAS

STATE OF KANSAS COUNTY OF RICE, ss.  
Noel J. Knight (employee of owner) or (~~CONTRACTOR~~) of the above-described


well, being first duly sworn on oath, says: That I have knowledge of the facts, statements, and matters herein contained and the log of the above-described well as filed and that the same are true and correct. So help me God.

(Signature) Noel J. Knight  
Chase, Kansas  
(Address)

SUBSCRIBED AND SWORN TO before me this 18th day of June, 1966

My commission expires May 20, 1968

Milton J. Volni  
Notary Public.

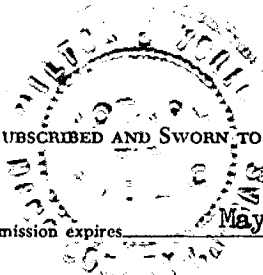

WELL LOG

1516900507-0000

DERBY OIL CO.  
Burk #5

Section 36, Twp 15, Rg. 4  
Saline County - Kansas

N/2 N/2 SW

Total Depth: 3438'  
Commenced: August 4, 1952  
Completed: August 16, 1952  
Drilled by Shields Drilling Co., Inc.

RECEIVED  
MAY 6 - 1966  
CONSERVATION DIVISION  
Wichita, Kansas

CASING RECORD

Size	Run	Cemented
8 5/8"	@ 340'	Cemented
5 1/2"	@ 3,437'	Cemented

Elevation: 1321'  
Treatment:  
Production:

	From	To
Surface Clay & Sand	0	45
Sand & Shale	45	50
Shale	50	104
Shale & Shells	104	222
Shale & Gyp	222	310
Anhydrite	310	340
Cemented 5 joints 8 5/8" surface - 353.75' @ 450' w/ 150 sax Posmix Cement		
Lime	340	370
Lime & Shale	370	500
Shale & Lime	500	690
Lime	690	755
Lime & Shale	755	885
Lime & Shale	885	1145
Lime & Shale & Salt	1145	1275
Shale & Lime	1275	1340
Shale	1340	1420
Lime & Shale	1420	1580
Lime & Shale	1580	1780
Lime & Shale	1780	1910
Lime & Shale	1910	2010
Lime & Shale	2010	2140
Shale	2140	2260
Lime & Shale	2260	2375
Lime & Shale	2375	2448
Shale & Lime	2448	2530
Lime & Shale	2530	2630
Lime & Shale	2630	2707
Shale	2707	2787
Shale & Lime	2787	2867
Shale	2867	2910
Lime & Shale	2910	2955
Shale & Lime	2955	2998
Shale	2998	3020
Lime & Shale	3020	3046
Lime & Shale	3046	3074
Lime & Shale	3074	3128
Shale	3128	3156
Lime & Shale	3156	3202
Shale	3202	3280
Shale	3280	3354
Lime & Shale	3354	3415
Lime & Shale	3415	3438 TD
Cemented 5 1/2" - 14# steel casing w/ 75 sax @ 3,437'		

TOPS

Miss	2910	Maq. Sh	3370
Kind.	3200	Maq. Sh	3436
Hunt	3356		