


STATE OF KANSAS
STATE CORPORATION COMMISSION

Give All Information Completely
Make Required Affidavit
Mail or Deliver Report to:
Conservation Division
State Corporation Commission
211 No. Broadway
Wichita, Kansas

15-169-19156-00-00

WELL PLUGGING RECORD

T - 15 NORTH R - 4W

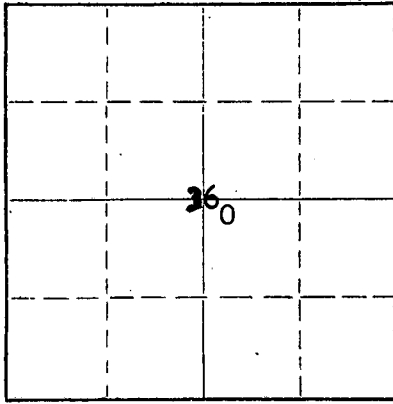

Locate well correctly on above Section Plat

Saline County. Sec. 36 Twp. 15S Rge. 4W (E) X (W)
Location as "NE/CNW/SW" or footage from lines NW - NW - SE
Lease Owner Frank J. Black
Lease Name Bengston Well No. 3
Office Address Box 150, McPherson, Kansas
Character of Well (completed as Oil, Gas or Dry Hole) Oil
Date well completed Feb. 21 1952
Application for plugging filed Dec. 7 1959
Application for plugging approved Dec. 11 1959
Plugging commenced Dec. 7 1959
Plugging completed Dec. 10 1959
Reason for abandonment of well or producing formation Unprofitable

If a producing well is abandoned, date of last production 19
Was permission obtained from the Conservation Division or its agents before plugging was commenced? Yes

Name of Conservation Agent who supervised plugging of this well Gilbert J. Toman
Producing formation _____ Depth to top _____ Bottom _____ Total Depth of Well 3419 Feet
Show depth and thickness of all water, oil and gas formations.

OIL, GAS OR WATER RECORDS

CASING RECORD

FORMATION	CONTENT	FROM	TO	SIZE	PUT IN	PULLED OUT
				8-5/8"	339'	None
				5-1/2"	3419'	2803'

Describe in detail the manner in which the well was plugged, indicating where the mud fluid was placed and the method or methods used in introducing it into the hole. If cement or other plugs were used, state the character of same and depth placed, from _____ feet to _____ feet for each plug set.


Fill hole with chat to 3410' & cement to 3375' - 5 sks.
Fill hole with mud to 330' & rock to 320' & run - 20 sks.
Fill hole with mud to 40' & rock to 30' & run - 10 sks.
Work started 12-7-59; Work completed 12-10-59

RECEIVED
STATE CORPORATION COMMISSION
DEC 21 1959
CONSERVATION DIVISION
WICHITA, KANSAS

(If additional description is necessary, use BACK of this sheet)
Name of Plugging Contractor Morgan Well Plugging Service License # 43
Address 102 West Eighteenth, Hutchinson, Kansas

STATE OF KANSAS, COUNTY OF MCPHERSON, ss.
Frank J. Black (owner or operator) of the above-described well, being first duly sworn on oath, says: That I have knowledge of the facts, statements and matters herein contained and the log of the above-described well as filed and that the same are true and correct. So help me God.

(Signature) [Handwritten Signature]
(Address) _____

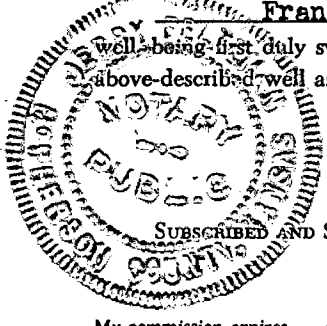

SUBSCRIBED AND SWORN TO before me this 15th day of December, 19 59
My commission expires July 16, 1963
Jerry Peltzman
JERRY PELTZMAN Notary Public.