

CARD MUST BE TYPED

State of Kansas
NOTICE OF INTENTION TO DRILL
(see rules on reverse side)

CARD MUST BE SIGNED

Starting Date:6-29-85.....
month day year

API Number 15- 051-24,256-00-00

OPERATOR: License # 5252
Name R.P. Nixon ~~d/b/a R.P. Nixon Oper~~
Address 207 West 12th
City/State/Zip Hays KS 67601
Contact Person Dan Nixon
Phone 913-628-3834

CONTRACTOR: License # 5128 Tag #36
Name Jay-Lan Corp.
City/State Hays KS 67601

Well Drilled For: Well Class: Type Equipment:
 Oil Swd Infield Mud Rotary
 Gas Inj Pool Ext. Air Rotary
 OWWO Expl Wildcat Cable

If OWWO: old well info as follows:

Operator
Well Name
Comp Date Old Total Depth
Projected Total Depth 3480 feet
Projected Formation at TD Arbuckle
Expected Producing Formations Lansing

PRODUCTION STRING WILL BE CEMENTED
THRU DAKOTA IMMEDIATELY UPON COMP. OF WELL

SE SE NW Sec 17 Twp 14 S Rge 16...
(location)
297.0 Ft North from Southeast Corner of Section
297.0 Ft West from Southeast Corner of Section
(Note: Locate well on Section Plat on reverse side)

Nearest lease or unit boundary line 330 feet.
County Ellis

Lease Name Joseph Well# 1
Domestic well within 330 feet: yes no
Municipal well within one mile: yes no

Depth to Bottom of fresh water 37 feet
Lowest usable water formation Dakota
Depth to Bottom of usable water 550 feet
Surface pipe by Alternate: 1 2 3 X
Surface pipe to be set .200 feet
Conductor pipe if any required none feet
Ground surface elevation N./A feet MSL

This Authorization Expires
Approved By
6-12-14-85
6-14-85

I certify that we will comply with K.S.A. 55-101, et seq., plus eventually plugging hole to K.C.C. specifications.

Date 6-10-85 .. Signature of Operator or Agent ..
Dan Nixon

RCR FOR KDHE

Title Geologist ..
[Signature]

Must be filed with the K.C.C. five (5) days prior to commencing well

This card void if drilling not started within six (6) months of date received by K.C.C.

RECEIVED
STATE CORPORATION COMMISSION

RECEIVED
STATE CORPORATION COMMISSION

JUN 11 1985

STATE CORPORATION COMMISSION

06-11-85


06-14-85
JUN 14 1985

A Regular Section of Land
1 Well at 5,280 Ft.

CONSERVATION DIVISION
Wichita, Kansas

Important procedures to follow:

1. Notify District office before setting surface casing.
2. Set surface casing by circulating cement to the top.
3. File completion forms ACO-1 with K.C.C. within 90 days of well completion, following instructions on ACO-1, side 1, and including copies of wireline logs.
4. Notify District office 48 hours prior to old well workover or re-entry.
5. Prior to plugging, prepare a plugging plan, then obtain agreement from the appropriate district office for an approved plugging plan.
6. Submit plugging report (CP-4) to K.C.C. after plugging is completed.
7. Obtain an approved injection docket number before disposing of salt water.
8. Notify K.C.C. within 10 days when injection commences or terminates.
9. If an alternate 2 completion, cement in the production pipe from below any usable water to surface within 120 days of spud date.

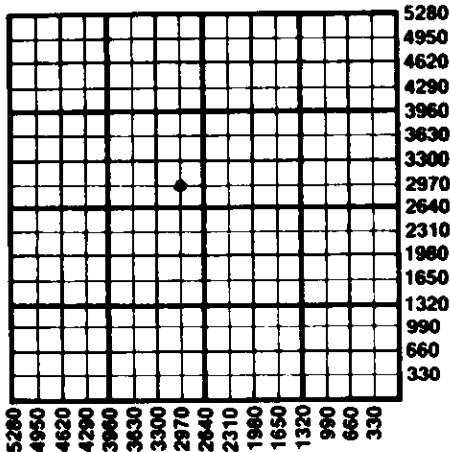

State Corporation Commission of Kansas
Conservation Division
200 Colorado Derby Building
Wichita, Kansas 67202
(316) 263-3238