

FOR KCC USE:

FORM C-1 7/91

State of Kansas

FORM MUST BE TYPED

NOTICE OF INTENTION TO DRILL

FORM MUST BE SIGNED

EFFECTIVE DATE

8-1-95

DISTRICT# 4

Must be approved by the K.C.C. five (5) days prior to commencing well

ALL BLANKS MUST BE FILLED

SGA?...Yes...No

Spot

EAST

EXPECTED SPUD DATE: 07 31 95
month day year

APPRX C N/2 NE NW Sec 13 Twp 14 S, Rg 13 WEST
4950 feet from (South) / North Line of Section

Operator: License#: 06246

3330 feet from (East) / West Line of Section

Name: BENNETT & SCHULTE

IS SECTION XX REGULAR IRREGULAR?

Address: P O BOX 329

NOTE: Locate well on the Section Plat on Reverse Side)

City/State/Zip: RUSSELL KS. 67665

COUNTY: RUSSELL

Contact Person: FRANK SCHULTE

LEASE NAME: REIN WELL#: 5

Phone: 913-483-2721

Field Name: MAHONEY WEST

CONTRACTOR: License # 9431

Is this a Prorated/Spaced Field? yes XX no

Name: VONFELDT DRILLING COMPANY

Target Formation(s): ARBUCKLE

Nearest lease or unit boundary: 330

Ground Surface Elevation: 1830 feet MSL

Water well within one-quarter mile: yes XX no

Public water supply well within one mile: yes XX no

Depth to bottom of fresh water: 260 180'

Depth to bottom of usable water: 380

Surface Pipe by Alternate: 1 XX 2

Length of Surface Pipe Planned to be set: 200

Length of Conductor Pipe required: NONE

Projected Total Depth: 3350

Formation at Total Depth: ARBUCKLE

Water Source for Drilling Operations:

well XX farm pond other

DWR Permit# APPL'D FOR

Will Cores Be Taken? yes XX no

If yes, proposed zone:

Well Drilled For: Well Class: Type Equipment:

XX Oil ___ Enh Rec XX Infield XX Mud Rotary
___ Gas ___ Storage ___ Pool Ext. ___ Air Rotary
___ OWMO ___ Disposal ___ Wildcat ___ Cable
___ Seismic; ___ # of Holes ___ Other

If OWMO: old well information as follows:

Operator: _____

Well Name: _____

Comp. Date: _____ Old Total Depth _____

Directional, Deviated or Horizontal wellbore? yes XX no

If yes, true vertical depth: _____

Bottom Hole Location _____

RECEIVED

KANSAS CORPORATION COMMISSION

AFFIDAVIT

The undersigned hereby affirms that the drilling, completion and eventual plugging of this well will comply with K.S.A. 55-101 et. seq.

JUL 27 1995

It is agreed that the following minimum requirements will be met:

1. Notify the appropriate district office prior to spudding of well.
2. A copy of the approved notice of intent to drill shall be posted on each drilling rig: CONSERVATION DIVISION
3. The minimum amount of surface pipe as specified below shall be set by circulating cement to the bottom of all cases surface pipe shall be set through all unconsolidated materials plus a minimum of 20 feet into the underlying formation
4. If the well is dry hole, an agreement between the operator and district office on plug length and placement is necessary prior to plugging:
5. The appropriate district office will be notified before well is either plugged or production casing is cemented in:
6. IF AN ALTERNATE II COMPLETION, PRODUCTION PIPE SHALL BE CEMENTED FROM BELOW ANY USABLE WATER TO SURFACE WITHIN (120) DAYS OF SPUD DATE. IN ALL CASES, NOTIFY DISTRICT OFFICE PRIOR TO ANY CEMENTING.

I hereby certify that the statements made herein are true and to the best of my knowledge and belief.

Date: 07/27/95

Signature of Operator or Agent: Laura M. Eads

Title AGENT

SEARCH INC., 316-265-5415

1447

FOR KCC USE:

API # 15- 167-231030000

Conductor Pipe required NONE feet

Minimum surface pipe required 200' feet per Alt. X(2)

Approved by: JK 7-27-95

This Authorization expires: 1-27-96

(This authorization void if drilling not started within 6 months of effective date.)

Spud date: _____ Agent: _____

REMEMBER TO:

- File Drill Pit Application (form CDP-1) with intent to Drill;
- File Completion Form ACO-1 within 120 days of spud date;
- File acreage attribution plat according to field proration orders;
- Notify appropriate district office 48 hour prior to workover or re-entry;
- Submit plugging report (CP-4) after plugging is completed;
- Obtain written approval before disposing or injecting salt water.

Mail to: KCC Conservation Office, Wichita State Office Building, 130 S. Market, Room 2078 Wichita, Ks 67202

13
14
13W

IN ALL CASES PLOT THE INTENDED WELL ON THE PLAT BELOW

PLAT OF ACREAGE ATTRIBUTABLE TO A WELL IN A PRORATED OR SPACED FIELD

If the intended well is in a prorated or spaced field, please fully complete this side of the form. If the intended well is in a prorated or spaced field complete the plat below showing that the well will be properly located in relationship to other wells producing from the common source of supply. Please show all the wells within 1 mile of the boundaries of the proposed acreage attribution unit for gas wells and within 1/2 mile of the boundaries of the proposed acreage attribution unit for oil wells.

API NO. 15- _____
 OPERATOR _____
 LEASE _____
 WELL NUMBER _____
 FIELD _____

LOCATION OF WELL: COUNTY _____
 _____ feet from (South) / North Line of Section
 _____ feet from (East) / West line of section
 SECTION _____ TWP _____ RG _____



ACRES ATTRIBUTABLE TO WELL _____
 QTR/QTR/QTR OF ACREAGE _____

IS SECTION XX REGULAR or _____ IRREGULAR
IF SECTION IS IRREGULAR, LOCATE WELL FROM NEAREST CORNER BOUNDARY

Section corner used: _____ NE _____ NW _____ SE _____ SW

PLAT

(Show location of the well and shade attributable acreage for prorated or spaced wells.)
 (Show footage to the nearest lease or unit boundary line.)

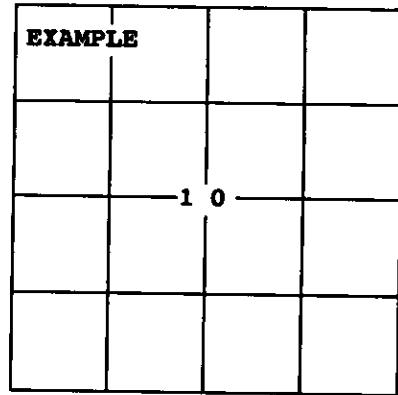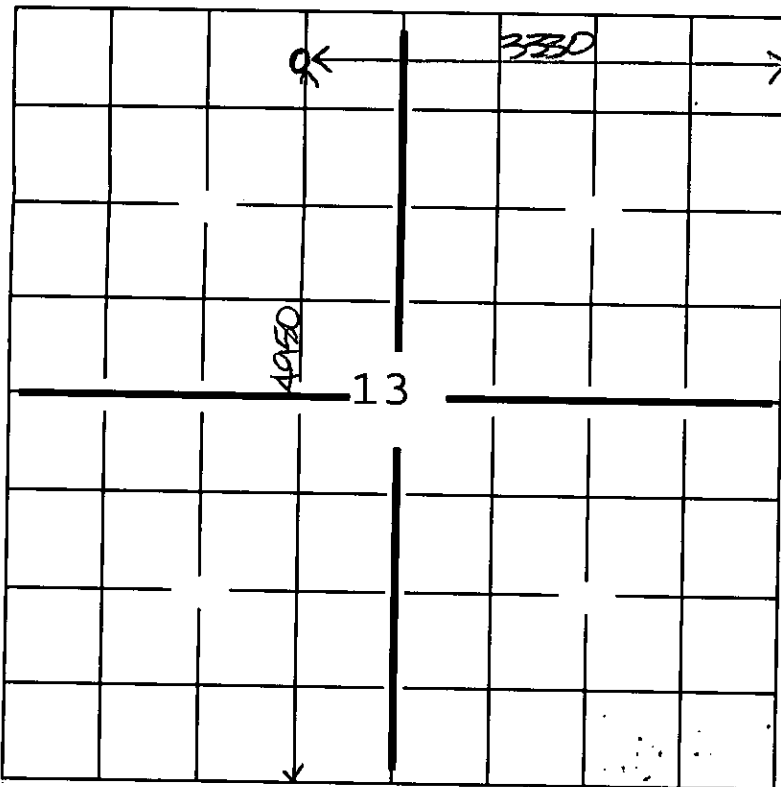

**40
ACRES**

SEWARD CO.

In plotting the proposed location of the well, you must show:

- 1) The manner in which you are using the depicted plat by identifying section lines, i.e. 1 section, 1 section with 8 surrounding sections, 4 sections, etc.;
- 2) the distance of the proposed drilling location from the section's south/north and east/west lines; and
- 3) the distance to the nearest lease or unit boundary line.