

MAIL TO: EMPHASIS 15-167-23088-0000 ALL BLANKS MUST BE FILLED

DISTRICT # D4  
SEAL Yes No

NOTICE OF INTENTION TO DRILL

Must be approved by the K.C.C. five (5) days prior to commencing well

Expected Spud Date August 24, 1994  
month day year

Section NE NE SE 32 Twp 14S R. 15 East West

OPERATOR: License # 6627  
Name: Prospect Oil & Gas Company  
Address: P. O. Box 837  
City/State/Zip: Russell, KS 67665  
Contact Person: Brad Hutchinson  
Phone: (913)-483-6266

2310 feet from South North line of Section  
330 feet from East West line of Section  
IS SECTION X REGULAR IRREGULAR

(NOTE: Locate well on the Section Plat on Reverse Side)

County: Russell  
Lease Name: Hartel Well #: 1  
Field Name:

CONTRACTOR: License #: 8241  
Name: Emphasis Oil Operations

Is this a Prorated/Spaced Field? yes X no  
Target Formation(s): Lansing-Kansas City - Arbuckle

Nearest lease or unit boundary: 330  
Ground Surface Elevation: EST 1875 feet MSL

Well Drilled For: Well Class: Type Equipment:  
X Oil ... Enh Rec ... X Infield X Mud Rotary  
Gas ... Storage ... Pool Ext. ... Air Rotary  
OAWO ... Disposal ... Wildcat ... Cable  
Seismic: # of Holes Other

Water well within one-quarter mile: yes X no  
Public water supply well within one mile: yes X no  
Depth to bottom of fresh water: 100'

Depth to bottom of usable water: 450'  
Surface Pipe by Alternate: 1 X 2

if OAWO: old well information as follows:  
Operator:  
Well Name:  
Comp. Date: Old Total Depth

Length of Surface Pipe Planned to be set: 200'  
Length of Conductor pipe required: NA

Projected Total Depth: 3450'  
Formation at Total Depth: Arbuckle

Water Source for Drilling Operations:  
well X farm pond other

Directional, Deviated or Horizontal wellbore? yes X no  
if yes, true vertical depth:  
Bottom Hole Location:

OUR Permit #:  
Will Cores Be Taken? yes X no

If yes, proposed zone:

AFFIDAVIT

I, the undersigned hereby affirm that the drilling, completion and eventual plugging of this well will comply with K.S.A. 55-501, et. seq.  
It is agreed that the following minimum requirements will be met:

- 1. Notify the appropriate district office prior to spudding of well;
- 2. A copy of the approved notice of intent to drill shall be posted on each drilling rig;
- 3. The minimum amount of surface pipe as specified below shall be set by circulating cement to the top of the target formation; surface pipe shall be set through all unconsolidated materials plus a minimum of 20 feet into the underlying formation;
- 4. If the well is dry hole, an agreement between the operator and the district office on plug length and placement is necessary prior to plugging;
- 5. The appropriate district office will be notified before well is either plugged or production casing is cemented in;
- 6. IF AN ALTERNATE II COMPLETION, PRODUCTION PIPE SHALL BE CEMENTED FROM BELOW ANY USABLE WATER TO SURFACE WITHIN 120 DAYS OF SPUD DATE. IN ALL CASES, NOTIFY DISTRICT OFFICE PRIOR TO ANY CEMENTING.

I hereby certify that the statements made herein are true and to the best of my knowledge and belief.  
Date: 8-16-94 Signature of Operator or Agent: Title: Agent

FOR KCC USE:  
API # 15- 167-23088-00-00  
Conductor pipe required NONE feet  
Minimum surface pipe required 200' feet per Alt. X B  
Approved by: CB 8/18/94  
This authorization expires: 2/18/95  
(This authorization void if drilling not started within 6 months of effective date.)  
Spud date: Agent:

REMEMBER TO:

- File Drill Pit Application (form CDP-1) with Intent to Drill;
- File Completion Form ACO-1 within 120 days of spud date;
- File acreage attribution plat according to field proration orders;
- Notify appropriate district office 48 hours prior to workover or re-entry;
- Submit plugging report (CP-4) after plugging is completed;
- Obtain written approval before disposing or injecting salt water.

Mail to: Conservation Division, 200 Colorado Derby Building, 202 W. First St., Wichita, Kansas 67202-1286

RECEIVED STATE CORPORATION COMMISSION AUG 18 1994 CONSERVATION DIVISION WICHITA, KANSAS

32  
14  
15

**PLAT OF ACREAGE ATTRIBUTABLE TO A WELL IN A PRORATED OR SPACED FIELD**

If the intended well is in a prorated or spaced field, please fully complete this side of the form. If the intended well is in a prorated or spaced field complete the plat below showing that the well will be properly located in relationship to other wells producing from the common source of supply. Please show all the wells within 1 mile of the boundaries of the proposed acreage attribution unit for gas wells and within 1/2 mile of the boundaries of the proposed acreage attribution unit for oil wells.

PI NO. 15- \_\_\_\_\_  
 OPERATOR \_\_\_\_\_  
 EASE \_\_\_\_\_  
 WELL NUMBER \_\_\_\_\_  
 FIELD \_\_\_\_\_

LOCATION OF WELL: COUNTY \_\_\_\_\_  
 \_\_\_\_\_ feet from south/north line of section  
 \_\_\_\_\_ feet from east/west line of section  
 SECTION \_\_\_\_\_ TWP \_\_\_\_\_ RG \_\_\_\_\_



NUMBER OF ACRES ATTRIBUTABLE TO WELL \_\_\_\_\_  
 TR/QTR/QTR OF ACREAGE \_\_\_\_\_

IS SECTION \_\_\_\_\_ REGULAR or \_\_\_\_\_ IRREGULAR  
**IF SECTION IS IRREGULAR, LOCATE WELL FROM NEAREST CORNER BOUNDARY.**

Section corner used: \_\_\_\_\_ NE \_\_\_\_\_ NW \_\_\_\_\_ SE \_\_\_\_\_ SW

**PLAT**

(Show location of the well and shade attributable acreage for prorated or spaced wells.)  
 (Show footage to the nearest lease or unit boundary line.)

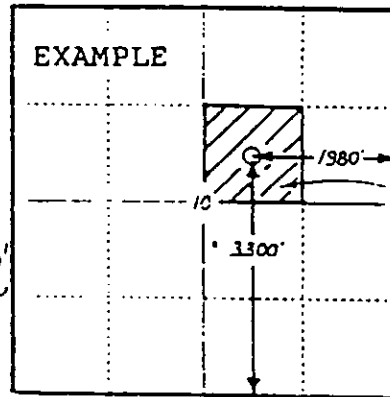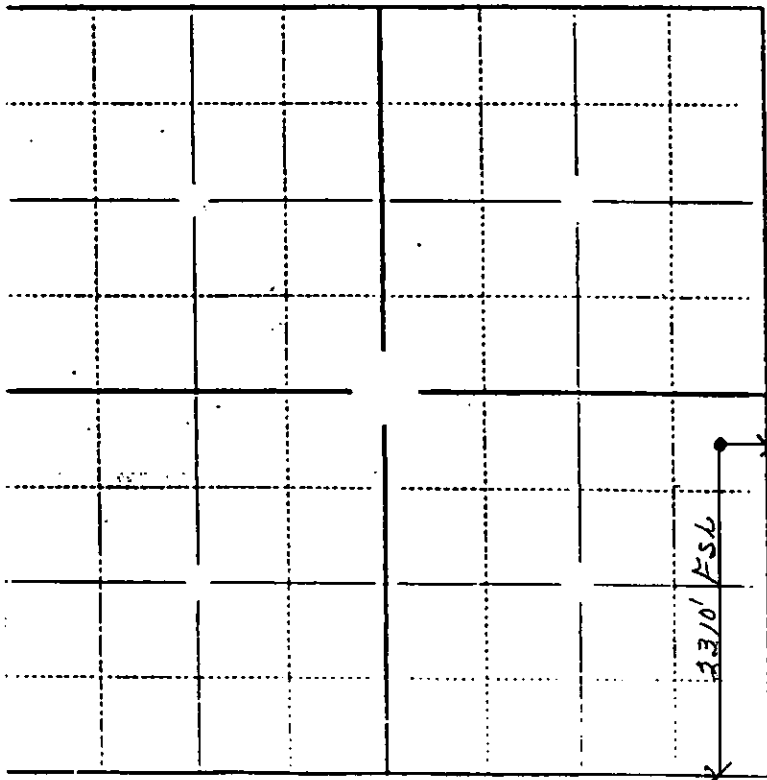

SEWARD CO.

In plotting the proposed location of the well, you must show:

- 1) The manner in which you are using the depicted plat by identifying section lines, i.e. 1 section, 1 section with 8 surrounding sections, 4 sections, etc.
- 2) the distance of the proposed drilling location from the section's south/north and east/west lines; and
- 3) the distance to the nearest lease or unit boundary line.