

CARD MUST BE TYPED

State of Kansas

CARD MUST BE SIGNED

NOTICE OF INTENTION TO DRILL

(see rules on reverse side)

JULY 25, 1987

Expected Spud Date.....

month day year

#3007

API Number 15-167-22,783-00-00

OPERATOR: License #.....

WESTERN KANSAS EXPLORATION

Name.....

2700 OAK

Address.....

HAYS, KANSAS 67601

City/State/Zip.....

Contact Person.....

(913) 628-2286

Phone.....

4083

CONTRACTOR: License #.....

WESTERN KANSAS DRILLING, INC.

Name.....

P.O. BOX 126, HAYS, KANSAS 67601

City/State.....

Well Drilled For: Well Class: Type Equipment:

X Oil Storage Infield Mud Rotary
Gas Inj Pool Ext Air Rotary
OWWO Expl Wildcat Cable

If OWWO: old well info as follows:

Operator.....

Well Name.....

Comp Date..... Old Total Depth.....

I certify that well will comply with K.S.A. 55-101, et seq., plus eventually plugging hole to KCC specifications.

Date 7-24-87 Signature of Operator or Agent

[Signature]

AS AGENT

For KCC Use:

Conductor Pipe Required..... feet; Minimum Surface Pipe Required..... feet per Alt. X 2

This Authorization Expires 1-24-88 Approved By PH 7-24-87

NE NE NW Sec. 30 Twp. 14 S. Rg. 15 West

4775

2970

Ft. from South Line of Section

Ft. from East Line of Section

(Note: Locate well on Section Plat on reverse side)

Nearest lease or unit boundary line 330 feet

County RUSSELL

Lease Name JACOBS-SCHRANT Well # 1

Ground surface elevation..... feet MSL

Domestic well within 330 feet: yes no

Municipal well within one mile: yes no

Depth to bottom of fresh water.....

Depth to bottom of usable water 1200 ~ 1400

Surface pipe by Alternate: 1 2 X

Surface pipe planned to be set 200

Conductor pipe required.....


Projected Total Depth 3350 feet

Formation ARBUCKLE

Must be filed with the K.C.C. five (5) days prior to commencing well
 This card void if drilling not started within six (6) months of date received by K.C.C.

Important procedures to follow:

A Regular Section of Land
1 Mile = 5,280 Ft.

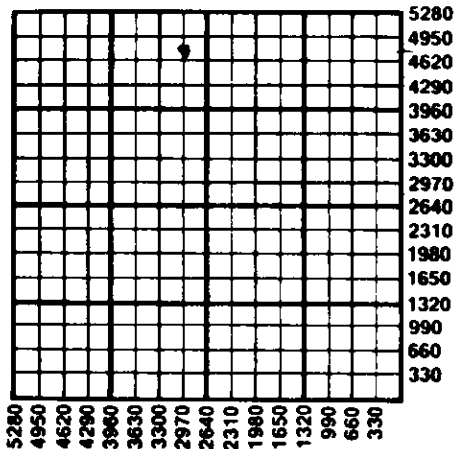

1. Notify District office before setting surface casing.
2. Set surface casing by circulating cement to the top.
3. File completion forms ACO-1 with K.C.C. within 120 days of well spud date, following instructions on ACO-1, side 1, and including copies of wireline logs.
4. Notify District office 48 hours prior to old well workover or re-entry.
5. Prior to filing Intent, prepare a proposed plugging plan in case well is D & A, then obtain approval of plan when calling district office prior to setting surface pipe.
6. Submit plugging report (CP-4) to K.C.C. after plugging is completed.
7. Obtain an approved injection docket number before disposing of salt water.
8. Notify K.C.C. within 10 days when injection commences or terminates.
9. If an alternate 2 completion, cement in the production pipe from below any usable water to surface within 120 days of spud date.

RECEIVED
 State Corporation Commission of Kansas
 Conservation Division
 200 Colorado Derby Building
 Wichita, Kansas 67202-1212
 (316) 263-3238

WICHITA, KANSAS
 DIVISION OF CONSERVATION
 JUL 24 1987

07-24-87