

CARD MUST BE TYPED

State of Kansas
NOTICE OF INTENTION TO DRILL

CARD MUST BE SIGNED

(see rules on reverse side)

Starting Date: 4 / 8 / 85
month day year

API Number 15- 063-20,899-00-00
 East

OPERATOR: License # 8362 (HBP) / 4000 SETCO
Name Held By Production, Inc./SETCO
Address 1625 Broadway, Suite 410
City/State/Zip Denver, Colorado 80202
Contact Person Marc T. Eckels
Phone 303/534-4445

..... Sec 11. Twp 14. S, Rge .. 27 West
(Location)

..... 990 Ft North from Southeast Corner of Section
..... 990 Ft West from Southeast Corner of Section
(Note: Locate well on Section Plat on reverse side)

CONTRACTOR: License # 5829
Name Aldebaran Drilling Co., Inc.
City/State Pratt, Kansas

Nearest lease or unit boundary line 990 feet.
County Gove
Lease Name Bird Well# 11-16-B

Well Drilled For: Well Class: Type Equipment:
 Oil Swd Infield Mud Rotary
 Gas Inj Pool Ext. Air Rotary
 OWWO Expl Wildcat Cable

Domestic well within 330 feet: yes no
Municipal well within one mile: yes no

If OWWO: old well info as follows:

Operator
Well Name
Comp Date Old Total Depth
Projected Total Depth 4,380 feet
Projected Formation at TD Mississippian
Expected Producing Formations Lansing & Mississippian

Depth to Bottom of fresh water 275.220 ^{mhc} feet
Lowest usable water formation Dakota
Depth to Bottom of usable water est. 1,100 feet
Surface pipe by Alternate: 1 2
Surface pipe to be set 225.740 ^{mhc} feet
Conductor pipe if any required NA feet
Ground surface elevation 2,518 feet MSL
This Authorization Expires 12-1-85
Approved By 4-1-85 ^{FE}

I certify that we will comply with K.S.A. 55-101, et seq., plus eventually plugging hole to K.C.C. specifications.

Date 3/27/85
Signature of Operator or Agent


Marc T. Eckels
Marc T. Eckels

Title Sec./Treasurer (SETCO, Inc.)

Form C-1 4/84
mhc 140HE 4-1-85

Must be filed with the K.C.C. five (5) days prior to commencing well
This card void if drilling not started within six (6) months of date received by K.C.C.

A Regular Section of Land
1 Mile = 5,280 Ft.

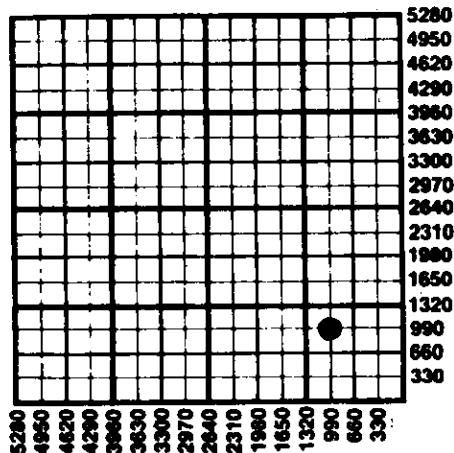

Important procedures to follow :

1. Notify District office before setting surface casing.
2. Set surface casing by circulating cement to the top.
3. File completion forms ACO-1 with K.C.C. within 90 days of well completion, following instructions on ACO-1, side I, and including copies of wireline logs.
4. Notify District office 48 hours prior to old well workover or re-entry.
5. Prior to plugging, prepare a plugging plan, then obtain agreement from the appropriate district office for an approved plugging plan.
6. Submit plugging report (CP-4) to K.C.C. after plugging is completed.
7. Obtain an approved injection docket number before disposing of salt water.
8. Notify K.C.C. within 10 days when injection commences or terminates.
9. If an alternate 2 completion, cement in the production pipe from below any usable water to surface within 120 days of spud date.

State Corporation Commission of Kansas
Conservation Division
200 Colorado Derby Building
Wichita, Kansas 67202
(316) 263-3238

APR - 1 1985
04-01-85