

CARD MUST BE TYPED

State of Kansas
NOTICE OF INTENTION TO DRILL
(see rules on reverse side)

CARD MUST BE SIGNED

Starting Date: 8 10 1985
month day year

API Number 15- 051-24,285-00-00

OPERATOR: License # 8061
Name Oil Producers, Inc. of Kansas
Address 1346 N. Woodlawn
City/State/Zip Wichita, Kansas 67208
Contact Person John S. Weir
Phone (316) 682-3022

1:45
St 50) NW, NW ... Sec .9.. Twp 14.. S, Rge 17...
(location) East West

..... 4020 Ft North from Southeast Corner of Section
..... 4950 Ft West from Southeast Corner of Section
(Note: Locate well on Section Plat on reverse side)

CONTRACTOR: License # 5122
Name Woodman-Iannitti
City/State Wichita, Kansas

Nearest lease or unit boundary line 330 feet.
County Ellis
Lease Name Sanders Well# 3

Well Drilled For: Well Class: Type Equipment:
 Oil Swd Infield Mud Rotary
 Gas Inj Pool Ext. Air Rotary
 OWWO Expl Wildcat Cable

Domestic well within 330 feet: yes no
Municipal well within one mile: yes no

If OWWO: old well info as follows:

Operator
Well Name
Comp Date Old Total Depth
Projected Total Depth 5600 feet
Projected Formation at TD
Expected Producing Formations

Depth to Bottom of fresh water 150 feet
Lowest usable water formation Dakota
Depth to Bottom of usable water 550 feet
Surface pipe by Alternate: 1 2 cement production
string from below
Surface pipe to be set 200 usable water feet
Conductor pipe if any required to surface feet
Ground surface elevation feet MSL.
This Authorization Expires 2-6-86
8-6-85

I certify that we will comply with K.S.A. 55-101, et seq., plus eventually plugging holes to K.C.C. specifications.

Date .. 8-06-85

Signature of Operator or Agent *John S. Weir*

Title President

RCA-KONE

RECEIVED


STATE CORPORATION COMMISSION

Must be filed with the K.C.C. five (5) days prior to commencing well
This card void if drilling not started within six (6) months of date received by K.C.C.

AUG 6 1985
08-06-1985

CONSERVATION DIVISION
Wichita, Kansas

A Regular Section of Land
1 Mile = 5,280 Ft.

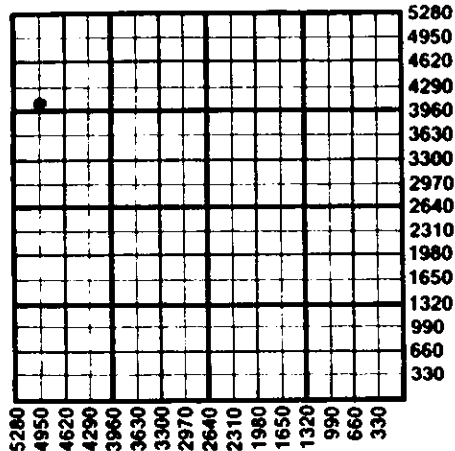

Important procedures to follow:

1. Notify District office before setting surface casing.
2. Set surface casing by circulating cement to the top.
3. File completion forms ACO-1 with K.C.C. within 90 days of well completion, following instructions on ACO-1, side 1, and including copies of wireline logs.
4. Notify District office 48 hours prior to old well workover or re-entry.
5. Prior to plugging, prepare a plugging plan, then obtain agreement from the appropriate district office for an approved plugging plan.
6. Submit plugging report (CP-4) to K.C.C. after plugging is completed.
7. Obtain an approved injection docket number before disposing of salt water.
8. Notify K.C.C. within 10 days when injection commences or terminates.
9. If an alternate 2 completion, cement in the production pipe from below any usable water to surface within 120 days of spud date.

State Corporation Commission of Kansas
Conservation Division
200 Colorado Derby Building
Wichita, Kansas 67202
(316) 263-3238