

CORRECTIVE

CORRECTION

CARD MUST BE TYPED

State of Kansas
NOTICE OF INTENTION TO DRILL

CARD MUST BE SIGNED

(see rules on reverse side)

7-2-85

Starting Date: 7 7 85
month day year

API Number 15- 063-20,937 -00-00

OPERATOR: License # 9067 and 6390
Name DaMar Resources, Inc. and
McDonald-Wallace Petroleum Co., Inc.
Address P. O. Box 70
City/State/Zip Hays, KS 67601
Contact Person Daniel F. Schippers
Phone (913) 625-0020

* N/2 NW/4 NE/4 Sec. 16 Twp. 14 S, Rge. 27 East
(location) West

* 4950 Ft North from Southeast Corner of Section
1980 Ft West from Southeast Corner of Section
(Note: Locate well on Section Plat on reverse side)

CONTRACTOR: License # 5145
Name Dreiling Oil, Inc.
City/State Victoria, KS 67671

Nearest lease or unit boundary line 330 feet.
County Gove
Lease Name Richardson Well# 1

Well Drilled For: Well Class: Type Equipment:
 Oil Swd Infield Mud Rotary
 Gas Inj Pool Ext. Air Rotary
 OWWO Expl Wildcat Cable

Domestic well within 330 feet: yes no
Municipal well within one mile: yes no

If OWWO: old well info as follows:
Operator
Well Name
Comp Date Old Total Depth
Projected Total Depth 4350 feet
Projected Formation at TD Mississippi
Expected Producing Formations Lans/Miss

Depth to Bottom of fresh water 100 feet
Lowest usable water formation Dakota
Depth to Bottom of usable water 1000 feet
Surface pipe by Alternate: 1 2
* Surface pipe to be set 300 feet
Conductor pipe if any required none feet
Ground surface elevation .. est. 2500 feet MSL
This Authorization Expires 12-25-85
Approved By 6-25-85

I certify that we will comply with K.S.A. 55-101, et seq., plus eventually plugging hole to K.C.C. specifications.

Date 7-1-85 Signature of Operator or Agent

Daniel F. Schippers


*4 qrs. NE 1/4 Sec 16 1650 F&C
OP will immediately come at prod. starting
P&S below usable water to the surface*
Title President

Must be filed with the K.C.C. five (5) days prior to commencing well
 This card void if drilling not started within six (6) months of date received by K.C.C.

RECEIVED
 STATE CORPORATION COMMISSION

FUL 02 1985
 CONSERVATION DIVISION
 Wichita, Kansas
 07-02-85

**A Regular Section of Land
 1 Mile = 5,280 Ft.**

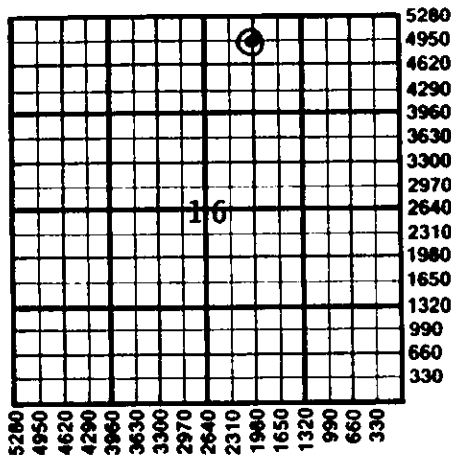

Important procedures to follow

1. Notify District office before setting surface casing.
2. Set surface casing by circulating cement to the top.
3. File completion forms ACO-1 with K.C.C. within 90 days of completion, following instructions on ACO-1, side 1, and including copies of wireline logs.
4. Notify District office 48 hours prior to old well workover or re-entry.
5. Prior to plugging, prepare a plugging plan, then obtain agreement from the appropriate district office for an approved plugging plan.
6. Submit plugging report (CP-4) to K.C.C. after plugging is completed.
7. Obtain an approved injection docket number before disposing of salt water.
8. Notify K.C.C. within 10 days when injection commences or terminates.
9. If an alternate 2 completion, cement in the production pipe from below any usable water to surface within 120 days of spud date.

State Corporation Commission of Kansas
 Conservation Division
 200 Colorado Derby Building
 Wichita, Kansas 67202
 (316) 263-3238