

CARD MUST BE TYPED

State of Kansas

CARD MUST BE SIGNED

NOTICE OF INTENTION TO DRILL

(see rules on reverse side)

Starting Date October 17, 1987
month day year

API Number 15- 109-20, 450-0000

OPERATOR: License # 8541

SE NE NE Sec 32 12 S, Rg 33 East XX West

4290 Ft. from South Line of Section
330 Ft. from East Line of Section

(Note: Locate well on Section Plat on reverse side)

Nearest lease or unit boundary line 330 feet
County Logan

Name PETEX, Inc
Address Route 2, Box 553
City/State/Zip Rogersville, MO 65742
Contact Person Larry Childress
Phone (417) 887-6289

CONTRACTOR: License # 3104

Lease Name Lee Well # 1
Ground surface elevation 3120 feet MSL

Domestic well within 330 feet: yes X no
Municipal well within one mile: yes X no

Name Blue Goose Drilling
City/State Great Bend, KS

Well Drilled For: Well Class: Type Equipment:
X Oil SWD Infield X Mud Rotary
Gas Inj Pool Ext Air Rotary
OWWO Expl X Wildcat Cable

Depth to bottom of fresh water 160'
Depth to bottom of usable water 1700'
Surface pipe by Alternate: 1 2 X

If OWWO: old well info as follows:

Surface pipe planned to be set 210
Conductor pipe required
Projected Total Depth 4700 feet
Formation Miss

Operator
Well Name
Comp Date Old Total Depth

I certify that well will comply with K.S.A. 55-101, et seq., plus eventually plugging hole to KCC specifications.

Date 10/10/87 Signature of Operator or Agent Larry Childress Title President

For KCC Use:

Conductor Pipe Required feet; Minimum Surface Pipe Required 200 feet per Alt. 1 (2)

This Authorization Expires 4-13-88 Approved By P.H. 10-13-87

10-18-87

Must be filed with the K.C.C. five (5) days prior to commencing well
This card void if drilling not started within six (6) months of date received by K.C.C.

Important procedures to follow:


1. Notify District office before setting surface casing.
 2. Set surface casing by circulating cement to the top.
 3. File completion forms ACO-1 with K.C.C. within 90 days of well completion, following instructions on ACO-1, side 1, and including copies of wireline logs.
 4. Notify District office 48 hours prior to old well workover or re-entry.
 5. Prior to filing Intent, prepare a proposed plugging plan in case well is D & A, then obtain approval of plan when calling district office prior to setting surface pipe.
- Submit plugging report (CP-4) to K.C.C. after plugging is completed.

Obtain an approved injection docket number before disposing of salt water.

Notify K.C.C. within 10 days when injection commences or terminates.

If an alternate 2 completion, cement in the production pipe from below any usable water to surface within 120 days of spud date.

**A Regular Section of Land
1 Mile = 5,280 Ft.**

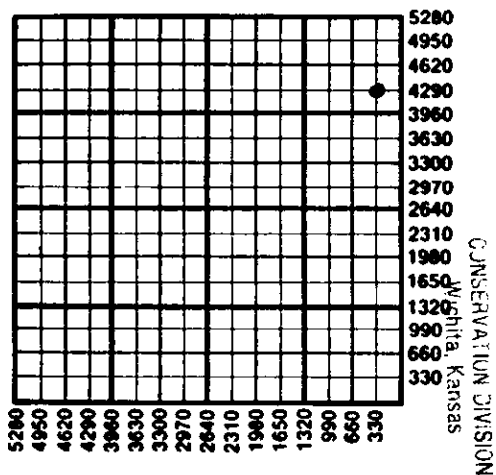

STATE CORPORATION COMMISSION
RECEIVED

OCT 13 1987

10-13-87

State Corporation Commission of Kansas
Conservation Division
200 Colorado Derby Building
Wichita, Kansas 67202
(316) 263-3238