


Give All Information Completely
Make Required Affidavit
Mail or Deliver Report to:
Conservation Division
State Corporation Commission
211 No. Broadway
Wichita, Kansas

15-051-00378-00-00

WELL PLUGGING RECORD

Ellis County, Sec. 32 Twp. 14S Rge. ~~16~~ 17 (W)

Location as "NE/CNWxSWx" or footage from lines SE SE NW
Lease Owner Peel-Hardman Oil Operators
Lease Name Pfannenstiel Well No. 1
Office Address R. R. #3, Box 144B, Wichita 15, Kansas
Character of Well (completed as Oil, Gas or Dry Hole) Dry Hole
Date well completed July 6, 19 59
Application for plugging filed July 6, 19 59
Application for plugging approved July 6, 19 59
Plugging commenced July 6, 19 59
Plugging completed July 6, 19 59
Reason for abandonment of well or producing formation Dry Hole

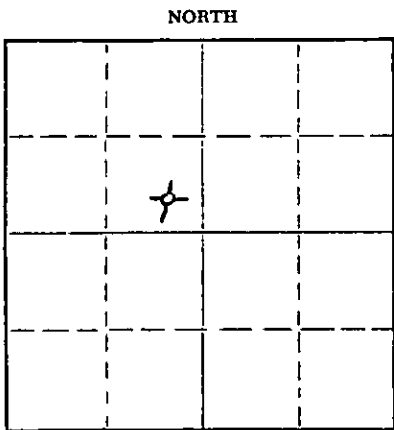

Locate well correctly on above Section Plat

If a producing well is abandoned, date of last production _____ 19____
Was permission obtained from the Conservation Division or its agents before plugging was commenced? Yes

Name of Conservation Agent who supervised plugging of this well _____
Producing formation _____ Depth to top _____ Bottom _____ Total Depth of Well 3501 Feet
Show depth and thickness of all water, oil and gas formations.

OIL, GAS OR WATER RECORDS

CASING RECORD

FORMATION	CONTENT	FROM	TO	SIZE	PUT IN	PULLED OUT
		0	210'	8 5/8"	210'	None

Describe in detail the manner in which the well was plugged, indicating where the mud fluid was placed and the method or methods used in introducing it into the hole. If cement or other plugs were used, state the character of same and depth placed, from _____ feet to _____ feet for each plug set.

Well plugged by Halliburton Oil Well Cementing Co.
Swedge welded in cellar and 125 sacks cement pumped
through by Halliburton Oil Well Cementing Co. Filled
w/cement to bottom of surface casing and below.

STATE CORPORATION COMMISSION
JUL 14 1959
07-14-1959
CONSERVATION DIVISION
Wichita, Kansas

(If additional description is necessary, use BACK of this sheet)

Name of Plugging Contractor _____
Address _____

STATE OF KANSAS, COUNTY OF SEDGWICK, ss.
William Herbert (employee of owner) or (owner or operator) of the above-described well, being first duly sworn on oath, says: That I have knowledge of the facts, statements, and matters herein contained and the log of the above-described well as filed and that the same are true and correct. So help me God.

(Signature) William Herbert
R. R. #3, Box 144B, Wichita 15, Kansas
(Address)

SUBSCRIBED AND SWORN to before me this 13th day of July, 1959

My commission expires March 4, 1962. Manan M. Herbert Notary Public.

PLUGGING
FILE SEC. 32 T 14 R 17 W
BOOK PAGE 51 LINE 1

15-051-00378-00-00

DRILLER'S LOG

Company: Peel-Hardman Oil Operators
Farm: Pfannenstiel Well No. 1
Total Depth: 3501'
Comm.: 6-24-59 Comp.: 7-6-59
Contractor: Glenn W. Peel Drilling Co.
Casing: 8 5/8" @ 210' cem.

Location: SE SE NW
Sec. 32, Twp. 14S, Rge. 17W,
County: Ellis,
Kansas
Elevations:
Production: Dry

Figures below indicate bottom of formations

Surface clay, shale and sand	0	210'
Shale and sand		840
Shale		1090
Anhydrite		1140
Shale		1180
Shale and shells		1675
Shale and lime		1975
Lime		2375
Lime and shale		2725
Lime		3460
Lime and Arbuckle		3501
Total Depth		3501

This is to certify that the above information is to the best of my knowledge true and correct.

GLENN W. PEEL DRILLING COMPANY

BY: Way Herbert

SUBSCRIBED AND SWORN TO before me this 13th day of July, 1959.

My commission expires March 4, 1962.

Marion M. Herbert
Notary Public

RECORDED
STATE COMMISSION
07-14-1959
JUL 14 1959
CONSERVED
WASH.

PLUGGING
FILE SEC. 32 T. 14 R. 17W
BOOK PAGE 51 LINE 1