


15-051-00444-00-00

STATE OF KANSAS  
STATE CORPORATION COMMISSION

Give All Information Completely  
Make Required Affidavit  
Mail or Deliver Report to:  
Conservation Division  
State Corporation Commission  
800 Bittling Building  
Wichita, Kansas

WELL PLUGGING RECORD

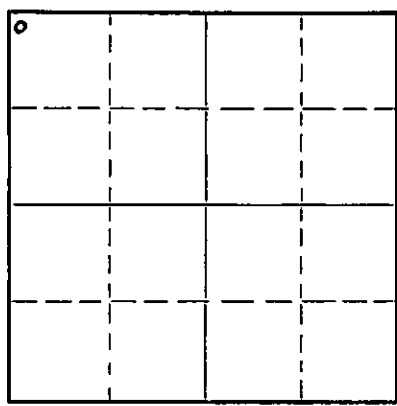

Locate well correctly on above  
Section Plat

Ellis County. Sec. 29 Twp. 14S Rge. (E) 17 (W)  
Location as "NE/CNW $\frac{1}{4}$ /SW $\frac{1}{4}$ " or footage from lines NW NW NW  
Lease Owner Brooks Pierce et al  
Lease Name Gross Well No. 1  
Office Address 1208 Union Nat'l Bank Bldg., Wichita, Kansas  
Character of Well (completed as Oil, Gas or Dry Hole) Dry Hole  
Date well completed May 1, 1951  
Application for plugging filed 19  
Application for plugging approved 19  
Plugging commenced May 1, 1951  
Plugging completed May 1, 1951  
Reason for abandonment of well or producing formation  
If a producing well is abandoned, date of last production 19  
Was permission obtained from the Conservation Division or its agents before plugging was commenced?

Name of Conservation Agent who supervised plugging of this well  
Producing formation Depth to top Bottom Total Depth of Well 3573 Feet  
Show depth and thickness of all water, oil and gas formations.

OIL, GAS OR WATER RECORDS

CASING RECORD

Formation	Content	From	To	Size	Put In	Pulled Out
Surface Pipe				8-5/8"	167'	None

Describe in detail the manner in which the well was plugged, indicating where the mud fluid was placed and the method or methods used in introducing it into the hole. If cement or other plugs were used, state the character of same and depth placed, from feet to feet for each plug set.

Hole filled with heavy mud to surface. Halliburton then set plug and pumped 50 sacks cement down and another plug was set. Solid cement plug in surface casing.

05-08-1951

(If additional description is necessary, use BACK of this sheet)

Correspondence regarding this well should be addressed to Brooks Pierce Drilling Co.  
Address 1208 Union Nat'l Bank Bldg.,  
Wichita 2, Kansas

STATE OF KANSAS, COUNTY OF SEDGWICK, ss.  
Brooks Pierce (employee of owner) or (owner or operator) of the above-described well, being first duly sworn on oath, says: That I have knowledge of the facts, statements, and matters herein contained and the log of the above-described well as filed and that the same are true and correct. So help me God.

(Signature) Brooks Pierce  
1208 Union Nat'l Bank Bldg., Wichita 2, Kansas  
(Address)

SUBSCRIBED AND SWORN to before me this 2nd day of May, 1951.

My commission expires September 8, 1954.  
Notary Public.

22-7877-6 4-49-10M


PLUGGING  
FILE SEC 29 T 14 R 17W  
BOOK PAGE 29 LINE 3V

BROOKS PIERCE DRILLING COMPANY  
UNION NATIONAL BANK BUILDING  
WICHITA 2, KANSAS

GROSS NO. 1  
NW NW NW of Sec. 29-14S-17W  
Ellis County, Kansas

<u>Formation</u>	<u>From</u>	<u>To</u>	<u>Remarks</u>
Surface Clay & Sand	0	60	8-5/8" Surface Pipe @ 167', cemented with 135 sacks of cement and 100 lbs. calcium chloride.
Shale & Shells	60	167	
Shale	167	275	
Shale & Shells	275	580	
Sand	580	800	
Red Bed	800	820	
Red Bed & Iron	820	910	
Red Bed	910	1015	
Red Bed & Shale	1015	1035	
Red Bed & Iron	1035	1140	
Anhydrite	1140	1185	
Red Bed and Shale	1185	1260	
Shale	1260	1400	
Shale & Shells	1400	1650	
Salt & Shale	1650	1750	
Shale & Shells	1750	1820	
Broken Lime	1820	2025	
Lime	2025	2330	
Black Shale	2330	2350	
Shale & Shells	2350	2705	
Shale & Lime	2705	2930	
Broken Lime	2930	3025	
Lime	3025	3465	
Conglomerate	3465	3515	
Cherty Conglomerate	3515	3534	
Conglomerate	3534	3545	
Arbuckle Lime	3545	3573	
Total Depth:		3573'	Plugged.

I hereby certify the foregoing to be a true and accurate Driller's Log of the formations encountered in the above well.

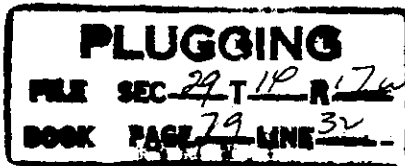

BROOKS PIERCE DRILLING COMPANY

By Brooks Pierce  
Brooks Pierce, Owner

Subscribed and sworn to before me this 2nd day of May, 1951.

Lewis K. Bowman  
Notary Public

My Commission expires September 8, 1954.