

15-053-00005-00-00

STATE OF KANSAS
STATE CORPORATION COMMISSION


WELL PLUGGING RECORD

Give All Information Completely
Make Required Affidavit
Mail or Deliver Report to:
Conservation Division
State Corporation Commission
800 Bittling Building
Wichita, Kansas

Ellsworth County, Sec. 8 Twp. 14 Rge. 10 (E) W (W)

Location as "NE/CNW $\frac{1}{4}$ SW $\frac{1}{4}$ " or footage from lines SW NE
Lease Owner B & R Drilling, Inc.
Lease Name Helen Kuck Well No. 1
Office Address Russell, Kansas
Character of Well (completed as Oil, Gas or Dry Hole) Dry Hole
Date well completed April 16, 1950 19
Application for plugging filed April 14, 1950 Verbally 19
Application for plugging approved April 14, 1950 Verbally 19
Plugging commenced April 15, 1950 19
Plugging completed April 15, 1950 19
Reason for abandonment of well or producing formation Dry Hole

NORTH

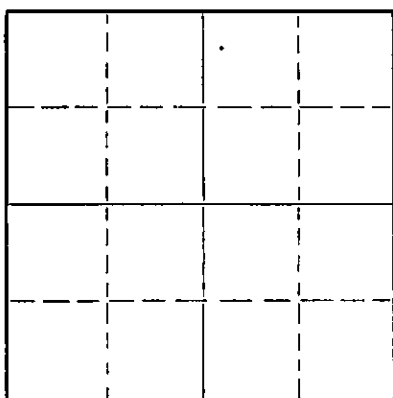

Locate well correctly on above Section Plat

If a producing well is abandoned, date of last production 19
Was permission obtained from the Conservation Division or its agents before plugging was commenced? Yes

Name of Conservation Agent who supervised plugging of this well Ruel Durkee
Producing formation Depth to top Bottom Total Depth of Well 3452' Feet
Show depth and thickness of all water, oil and gas formations.

OIL, GAS OR WATER RECORDS

CASING RECORD

Formation	Content	From	To	Size	Put In	Pulled Out
				8 5/8"	260'	None

Describe in detail the manner in which the well was plugged, indicating where the mud fluid was placed and the method or methods used in introducing it into the hole. If cement or other plugs were used, state the character of same and depth placed, from.....feet tofeet for each plug set.

Plugging Record

Run drill pipe to bottom and circulated 1 1/2 hours. Waiting on orders. Layed down 1/2 drill pipe. Gunned pits and filled hole with 12 pounds of Mud. Layed down rest of drill pipe. Pushed bottom plug to 240'. Put 10 loose rocks on plug then 15 sax of cement through drill pipe. Filled hole to 15' wooden plug and 5 sax cement. Mixed in barrel

04-29-50

(If additional description is necessary, use BACK of this sheet)

Correspondence regarding this well should be addressed to B & R Drilling, Inc.
Address Russell, Kansas

STATE OF Kansas COUNTY OF Russell, ss.

Don Roberts (employee of owner) or (owner or operator) of the above-described well, being first duly sworn on oath, says: That I have knowledge of the facts, statements, and matters herein contained and the log of the above-described well as filed and that the same are true and correct. So help me God.

(Signature) Don Roberts

Russell, Kansas

(Address)

SUBSCRIBED AND SWORN to before me this 27th day of April, 1950

My commission expires 6-17-50

Notary Public.

PLUGGING
FILE SEC 8 Twp 14 Rge 10 W
BOOK PAGE 107 14

15-053-00005-00-00

B & R Drilling, Inc.
Helen Kuck #1

SW NE Sec. 8-14-10
Ellsworth County, Kansas

Total Depth: 3452'
Comm: 4/1/50
Comp: 4/16/50

Casing

8 5/8" Set @ 260'

Cement

165 Sacks of Lone Star

Formation	Depth:
Surface Clay-Shale-Shells	210
Sand-Shale	225
Shale-Shells	380
Sand	440
Shale-Pyrite	485
Shale-Redbed	590
Anhydrite	625
Shale	655
Shale-Redbed	860
Shale	1110
Shale-Salt	1250
Shale-Lime	1335
Shale-Lime	2516
Lime	3296
Conglomerate	3314
Viola Lime	3348
Shale-Lime	3427
Lime	3452

STATE OF KANSAS)
)SS
RUSSELL COUNTY)

I hereby certify that the above information is true and correct to the best of my knowledge.

Violet Feller

Subscribed and sworn to before me this 27th day of April, 1950.

Clara L. Linn
Notary Public

My commission expires: 6-17-50

LOGGING
SEC 8 T 14 R 10W
BOOK PAGE 1 LINE 14